



T. 28 S., R. 8 W., W.M., Section 19

RECEIVED

MAY 24 2000

**WATER RESOURCES DEPT
SALEM, OREGON**

**Diversion is:
1628 ft. South and
1348 ft. West of the
NE cor. Sec. 19**

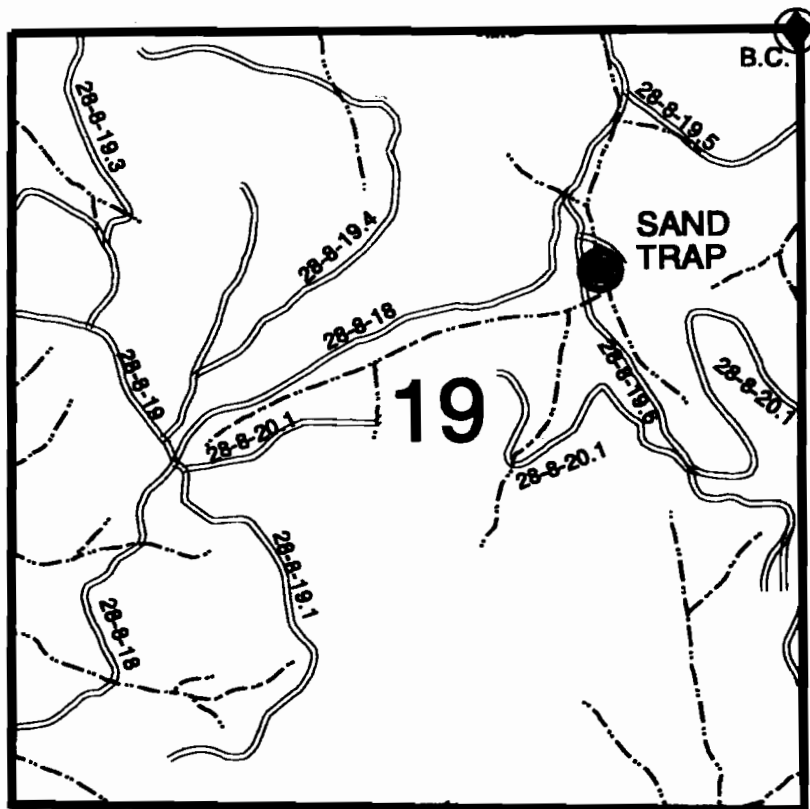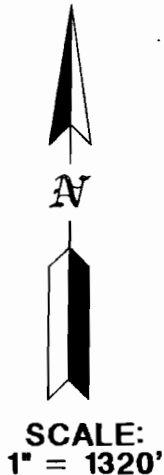


CLAIM OF BENEFICIAL USE MAP

in name of

UNITED STATES BUREAU OF LAND MANAGEMENT

**Application No.: R - 70702
S - 70513**

**Permit No.: R - 11764
52038**

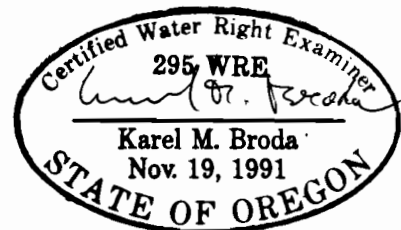

Expires: 12/31/01


SURVEYED: March 22, 2000

THIS MAP WAS PREPARED FOR THE PURPOSE OF IDENTIFYING THE LOCATION OF A WATER RIGHT ONLY
AND IS NOT INTENDED TO PROVIDE LEGAL DIMENSIONS OR LOCATION OF PROPERTY OWNERSHIP LINES.

U.S. Bureau of Land Management
Roseburg District Office
Division of Operations

Executed by:
Karel M. Broda, PE, CWRE
777 N.W. Garden Valley Blvd.
Roseburg, Oregon 97470

FINAL PROOF MAP

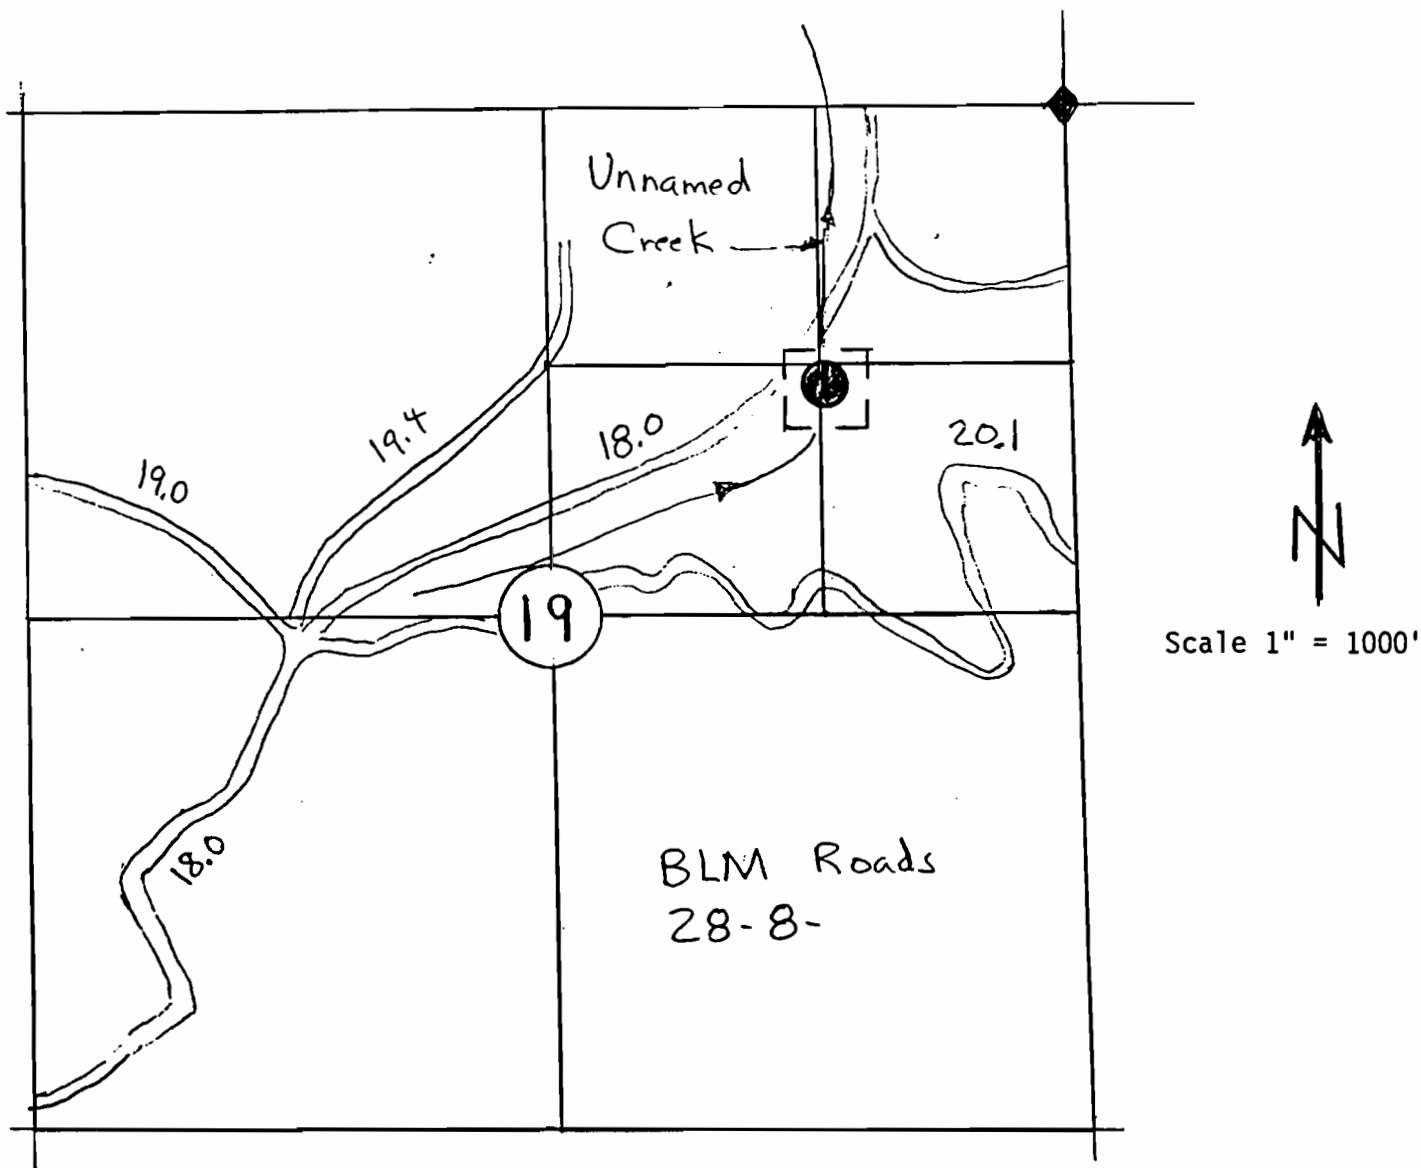


SAND TRAP RESERVOIR
T28S R8W Sec 19
S $\frac{1}{2}$, NE $\frac{1}{4}$

The point of diversion is located 1450 ft South and 1350 ft West from the Northeast Section corner of Section 19.

Coordinate Ties are based on aerial photo 2-5-27-89.

The map is shown for the purpose of water application and not property boundary.

Application No.: 70513, R. 70702
Permit No.: 70513

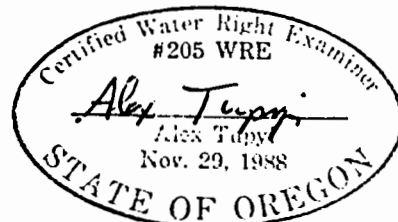

3-5-90