


ArcGIS Web Map

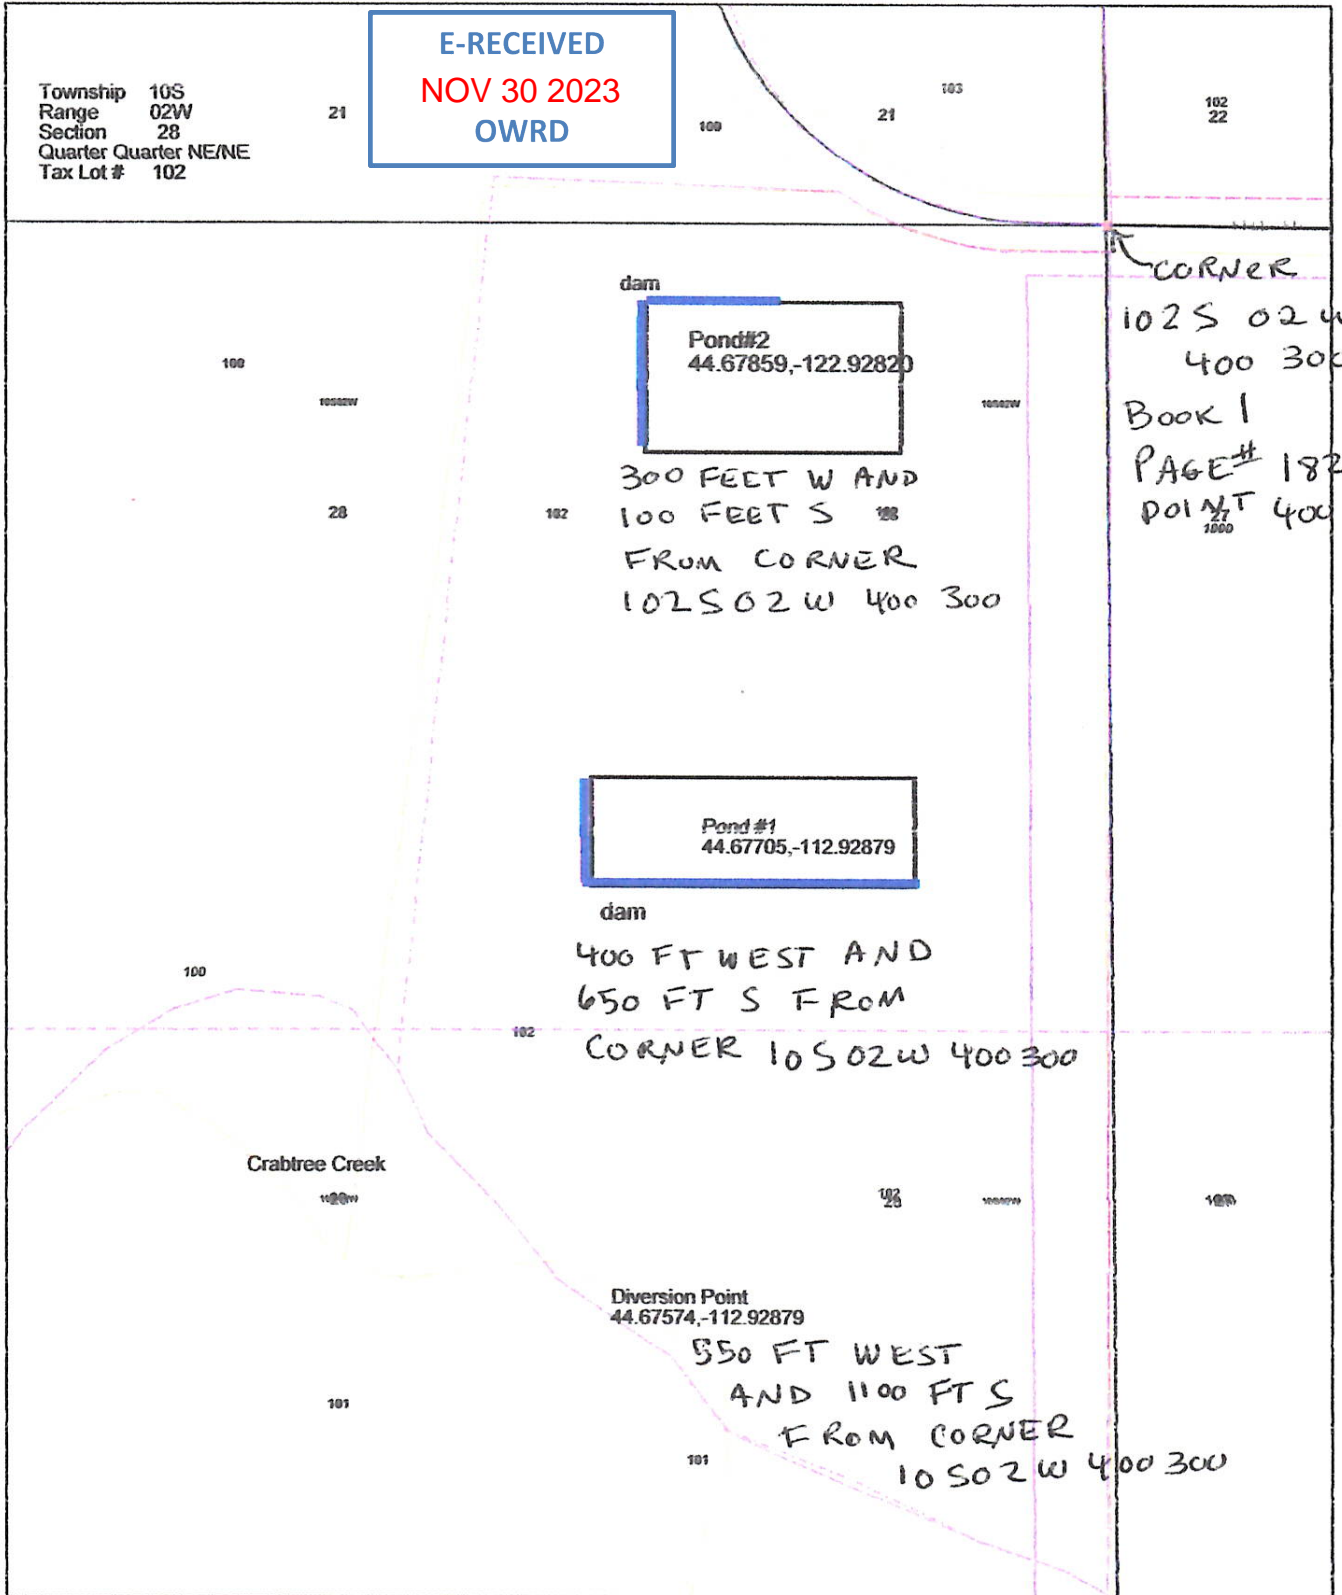

9/15/2023, 11:15:24 AM

- Townships
- County Boundary
- Surveys
- Section Corners
- Cities
- Sections
- Highways
- Roads
- Tax Lots

SCALE
1 inch =
200 FT



Linn County
State of Oregon
Canada, Esri,
EPA, USDA