

Request for Assignment

OREGON



WATER RESOURCES
DEPARTMENT

Oregon Water Resources Department
725 Summer Street NE, Suite A
Salem, Oregon 97301-1266
(503) 986-0900
www.oregon.gov/owrd

If the Department determines that the application is incomplete, fees have not been paid, or the required documents are not acceptable, the application and all fees submitted will be returned to the applicant.

If for multiple rights, a separate form and fee for each right will be required.

I, Peila Ranch Inc
(Name of Current Holder of Record)

PO Box 697
(Mailing Address)

BURNS OR 97720
(City) (State) (Zip)

(Phone #)

☐ hereby assign all my interest in and to the entire application/permit/transfer order/limited license/groundwater statement; (example, sold all the land authorized under the right)

☒ hereby assign all my interest in and to a portion of application/permit/transfer order/limited license/groundwater statement; (You must include a map showing the portion of the application/permit/transfer order/limited license/groundwater statement to be assigned. Example, sold a portion of the land authorized under the right)

☐ hereby assign a portion of my interest in and to the entire application/permit/transfer order/limited license/groundwater statement; (example, adding an additional person)

Application # 6-16809; Permit # 6-16259; Transfer Order # _____;

Limited License # _____; Groundwater Statement # _____;

as filed in the office of the Water Resources Director, to:

Eggle Ranch Inc.
(Name of New Owner)

PO Box 723
(Mailing Address)

HINES OR 97738
(City) (State) (Zip)

(Phone #)

Note: If there are other owners of the property described in the application, permit, transfer order, limited license, or groundwater statement, you must provide a list of all other owners' names and mailing addresses and attach it to this form. Write the initials (first letters) of your first and last names at the spot indicated below.

☒ I hereby certify that I have notified all other owners of the property described in this application, permit, transfer order, limited license, or groundwater statement of this Request of Assignment.

Witness my hand this 23 day of 7, 20 23
(Day) (Month) (Year)

Signature of Current Holder of Record Peila Ranch Inc. [Signature]

Failure to provide any of the required information will result in the return of your application.

This certifies assignment and record change at Oregon Water Resources Department effective 8:00 a.m. on date of receipt at Salem, Oregon.

Fee receipt # 141948

For Director by Mary F. Bjork, Program Analyst in Water Rights Division. MAB

The completed "Request for Assignment" form *must* be submitted to the Department along with the recording fee of \$120.

RECEIVED

NOV 03 2023

OWRD
SALEM, OREGON

Last updated: July 20, 2021

Request for Assignment

RECEIVED

NOV 17 2023

OWRD

part assign - approve
WSD
11-27-2023

RECEIVED

NOV 17 2023

OWRD


FINAL PROOF MAP

TO SHOW PLACES OF USE AND
POINTS OF APPROPRIATION
FOR APPLICATION G-16809
PEILA RANCH, INC.

SECTION 19, TOWNSHIP 27 SOUTH, RANGE 23 EAST, W.M.
TAX LOTS: 1000 & 1300, LAKE COUNTY, OREGON


- #4 (LAKE 51882) PERMIT: G-16259
LOCATED IN THE NW 1/4 OF THE SE 1/4 & 1340' NORTH
& 1345' WEST FROM THE SE CORNER OF SECTION 18.
FLOW METER IS 10.5' EAST FROM WELL.
- #5 (LAKE 51884) PERMIT: G-16259
LOCATED IN THE NE 1/4 OF THE SW 1/4 & 1420' SOUTH
& 1355' WEST FROM THE NE CORNER OF SECTION 19.
FLOW METER S 11.0' NORTH FROM WELL.

BURIED 8 INCH STEEL PIPE

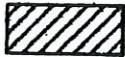-  137.5 ACRES PRIMARY IRRIGATION FROM
#4 (G-16259), AS SHOWN
-  108.3 ACRES PRIMARY IRRIGATION FROM
#5 (G-16259), AS SHOWN

RECEIVED BY OWRD

APR 11 2014

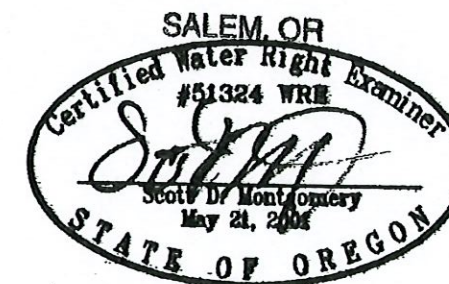

RENEWAL DATE: 12/31/2014

THIS MAP IS FOR THE PURPOSE OF LOCATING A WATER
RIGHT ONLY AND HAS NO INTENT TO PROVIDE LEGAL
DIMENSIONS OR THE LOCATION OF PROPERTY LINES


PREPARED FOR:
PEILA RANCH, INC.
P.O. BOX 697
BURNS, OR 97720

PREPARED BY:



ALL POINTS ENGINEERING AND SURVEYING, INC.
P.O. BOX 767
(541) 548-5833
TERREBONNE, OR 97760
www.APEandS.com

SCALE: 4 INCHES = 1 MILE

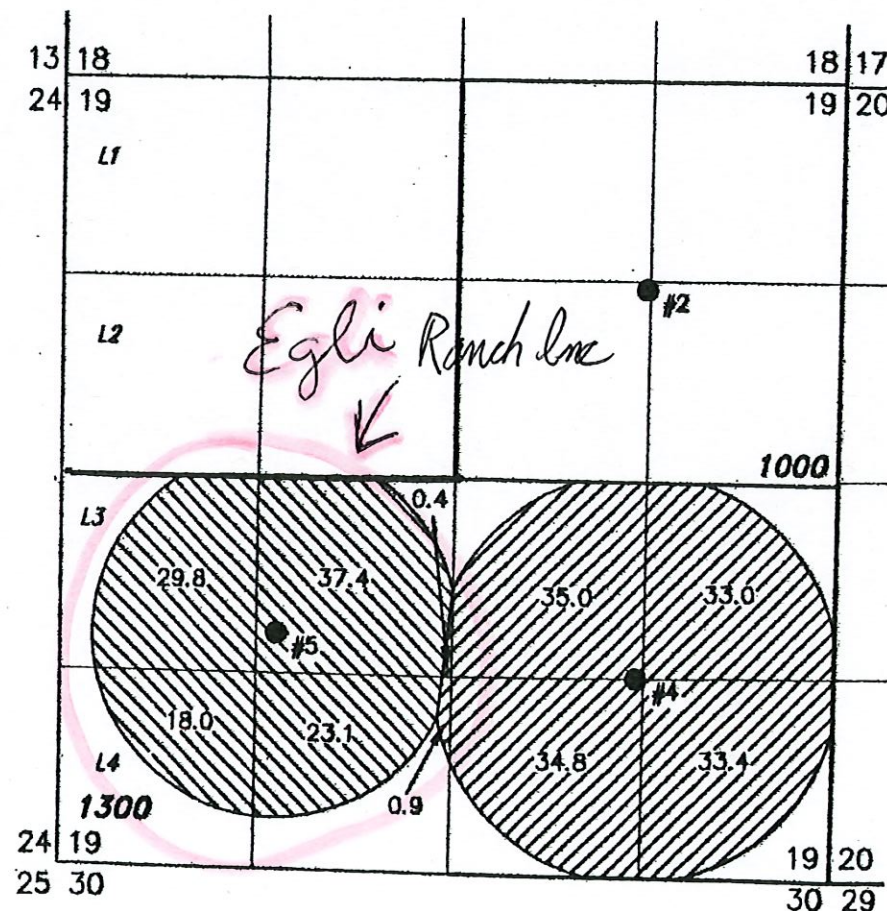

COBU MAP # 822