


RECEIVED
JUN 26 1978
WATER RESOURCES DEPT.
SALEM, OREGON

TWP 39 SOUTH
RANGE 5 W., W. M.
SECTION 2

JOSEPHINE COUNTY
SCALE: 1" = 400'

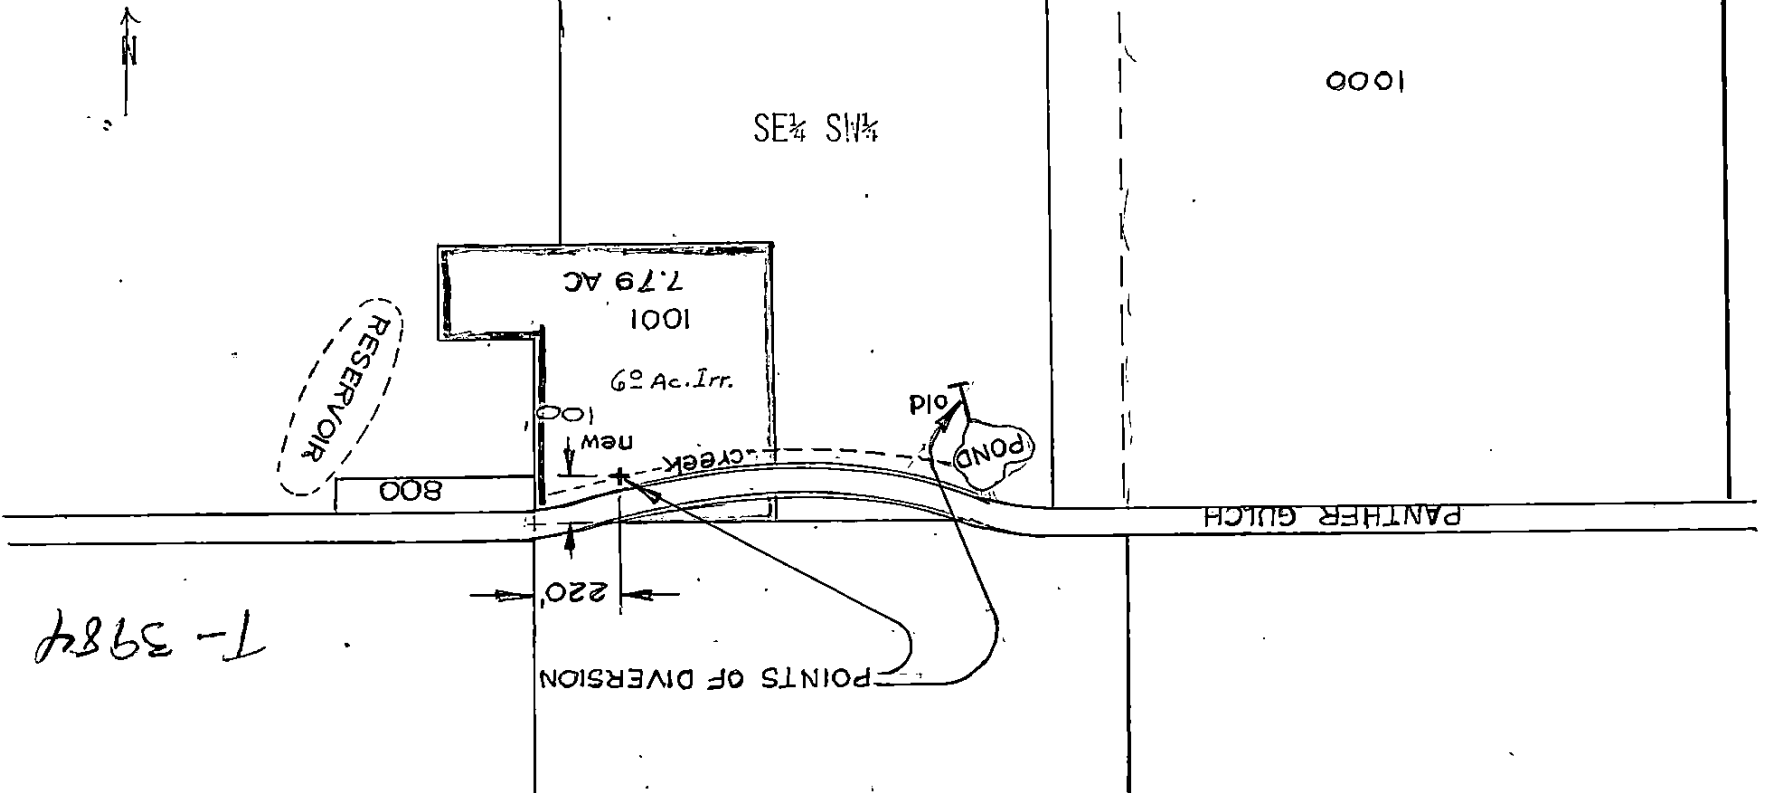

T-3984