



T18S R1W, WM

LANE COUNTY

**John M &
Mary Ann
Stewart
Warner
DLC 39**

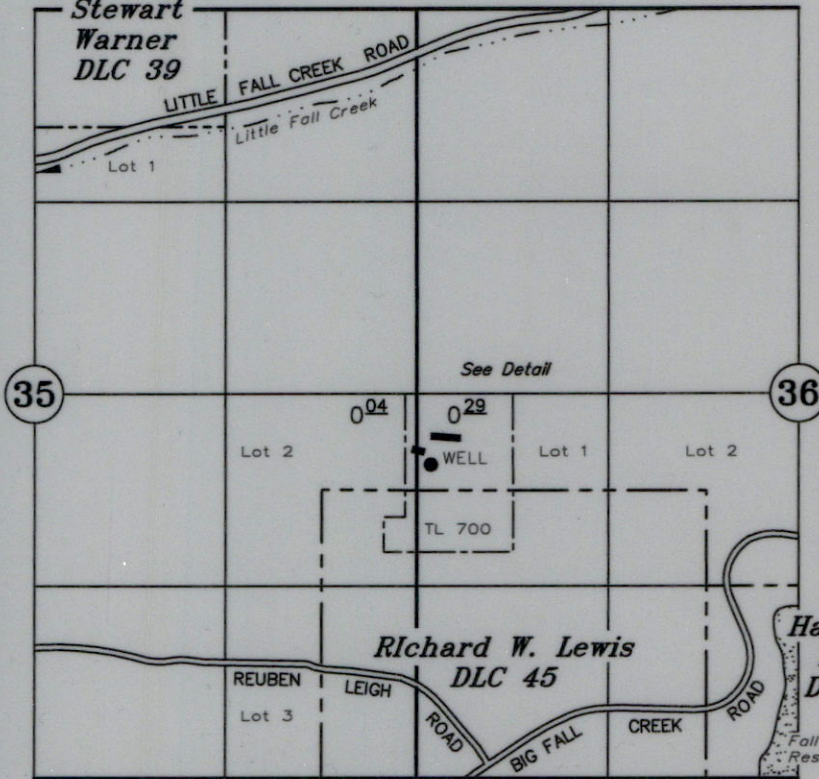

1/4 COR

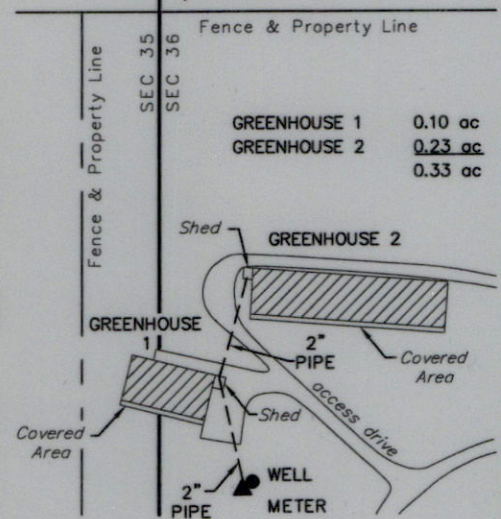

GREENHOUSE 1 0.10 ac
GREENHOUSE 2 0.23 ac
0.33 ac

Shed GREENHOUSE 2

GREENHOUSE 1

2" PIPE

Covered Area

Shed

access drive

WELL

METER

Detail

Scale: 1" = 200'

TAX LOT: 18 1W 36 700

▲ METER

● WELL

----- DLC LINE

----- TAX LOT LINE

▨ IRRIGATED AREA

WELL: 488' SOUTH AND 98' EAST FROM THE W 1/4 CORNER SEC 36

METER: 493' SOUTH AND 95' EAST FROM THE W 1/4 CORNER SEC 36

CLAIM OF BENEFICIAL USE

Application No. G-18337


Permit No. G-17863

GRATEFUL GREENERY

September 27, 2023

SCALE: 1" = 1320'

NOTE: This map is for the purpose of identifying the location of water rights and has no intent to dimension or locate property ownership lines.

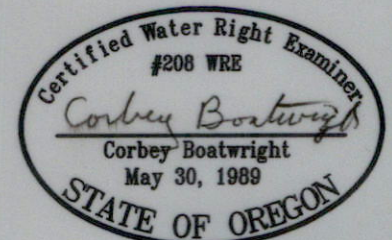

Renews: December 31, 2023

RECEIVED
DEC 11 2023
OWRD