


RECEIVED

OCT 15 2019

OWRD

TOWNSHIP 19 SOUTH, RANGE 12 WEST, W.M.

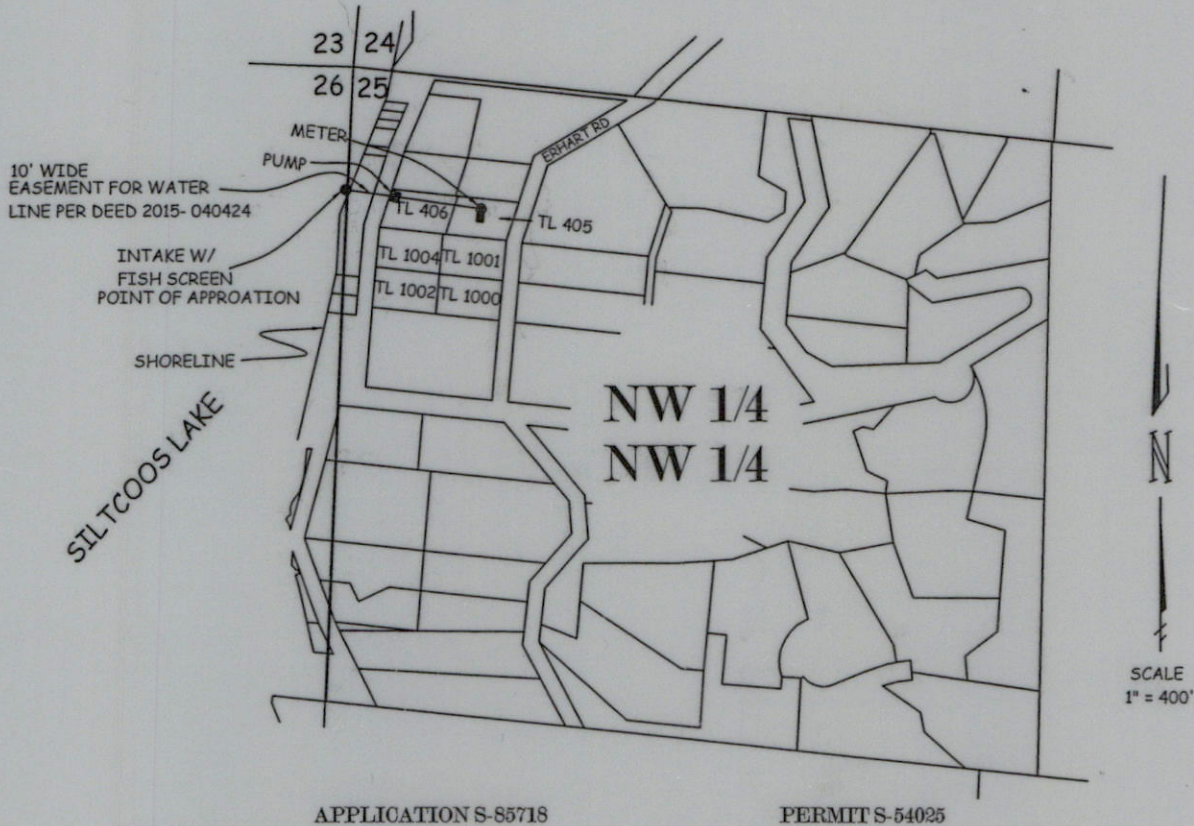

APPLICATION S-85718

PERMIT S-54025

LEGEND

- DENOTES HOUSE LOCATION
- DENOTES POINT OF APPROPRIATION LOCATION  
255' SOUTH & 15' WEST OF NW COR. SEC. 25  
DENOTES POINT OF APPROPRIATION LOCATION
- ⊠ DENOTES PUMP LOCATION  
270' SOUTH & 85' EAST OF NW COR. SEC. 25  
DENOTES POINT OF APPROPRIATION LOCATION
- DENOTES PUMP LOCATION  
295' SOUTH & 264' EAST OF NW COR. SEC. 25  
DENOTES POINT OF APPROPRIATION LOCATION

SEE TAX MAP NO. 19-12-25-22 FOR TAX LOT INFO.  
 THIS MAP WAS PREPARED FOR THE PURPOSE  
 OF IDENTIFYING THE LOCATION OF THE WATER  
 RIGHT ONLY. IT IS NOT INTENDED TO PROVIDE  
 DIMENSIONS OR LOCATION OF PROPERTY  
 OWNERSHIP LINES.

FINAL PROOF SURVEY

FOR

McFarland Trust

83418 ERHART ROAD

FLORENCE, OR. 97439

BY

H. TIMOTHY FASSBENDER, PLS, CWRE

2896 SARAH LANE

EUGENE, OR. 97408

AUGUST 20, 2019

