


# T. 6 & 7 S., R. 2 W., W.M.

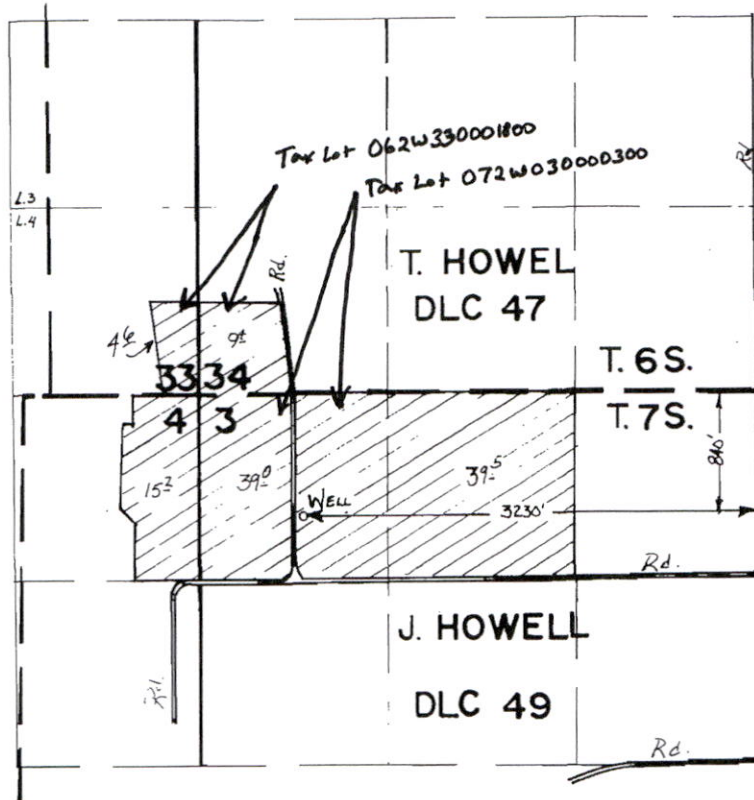

SCALE 4" = 1 mi

Acres - Nursery  
 4.6  
 9.4  
 39.5  
 39  
15.2  
 107.7 Acres - Nursery

RECEIVED

DEC 12 2023

OWRD