


Map to accompany
Dyke Properties LLC
Ground water application

T. 7 S., R. 38 E



Supplemental
Irrigation

Scale: 1" = 1320'

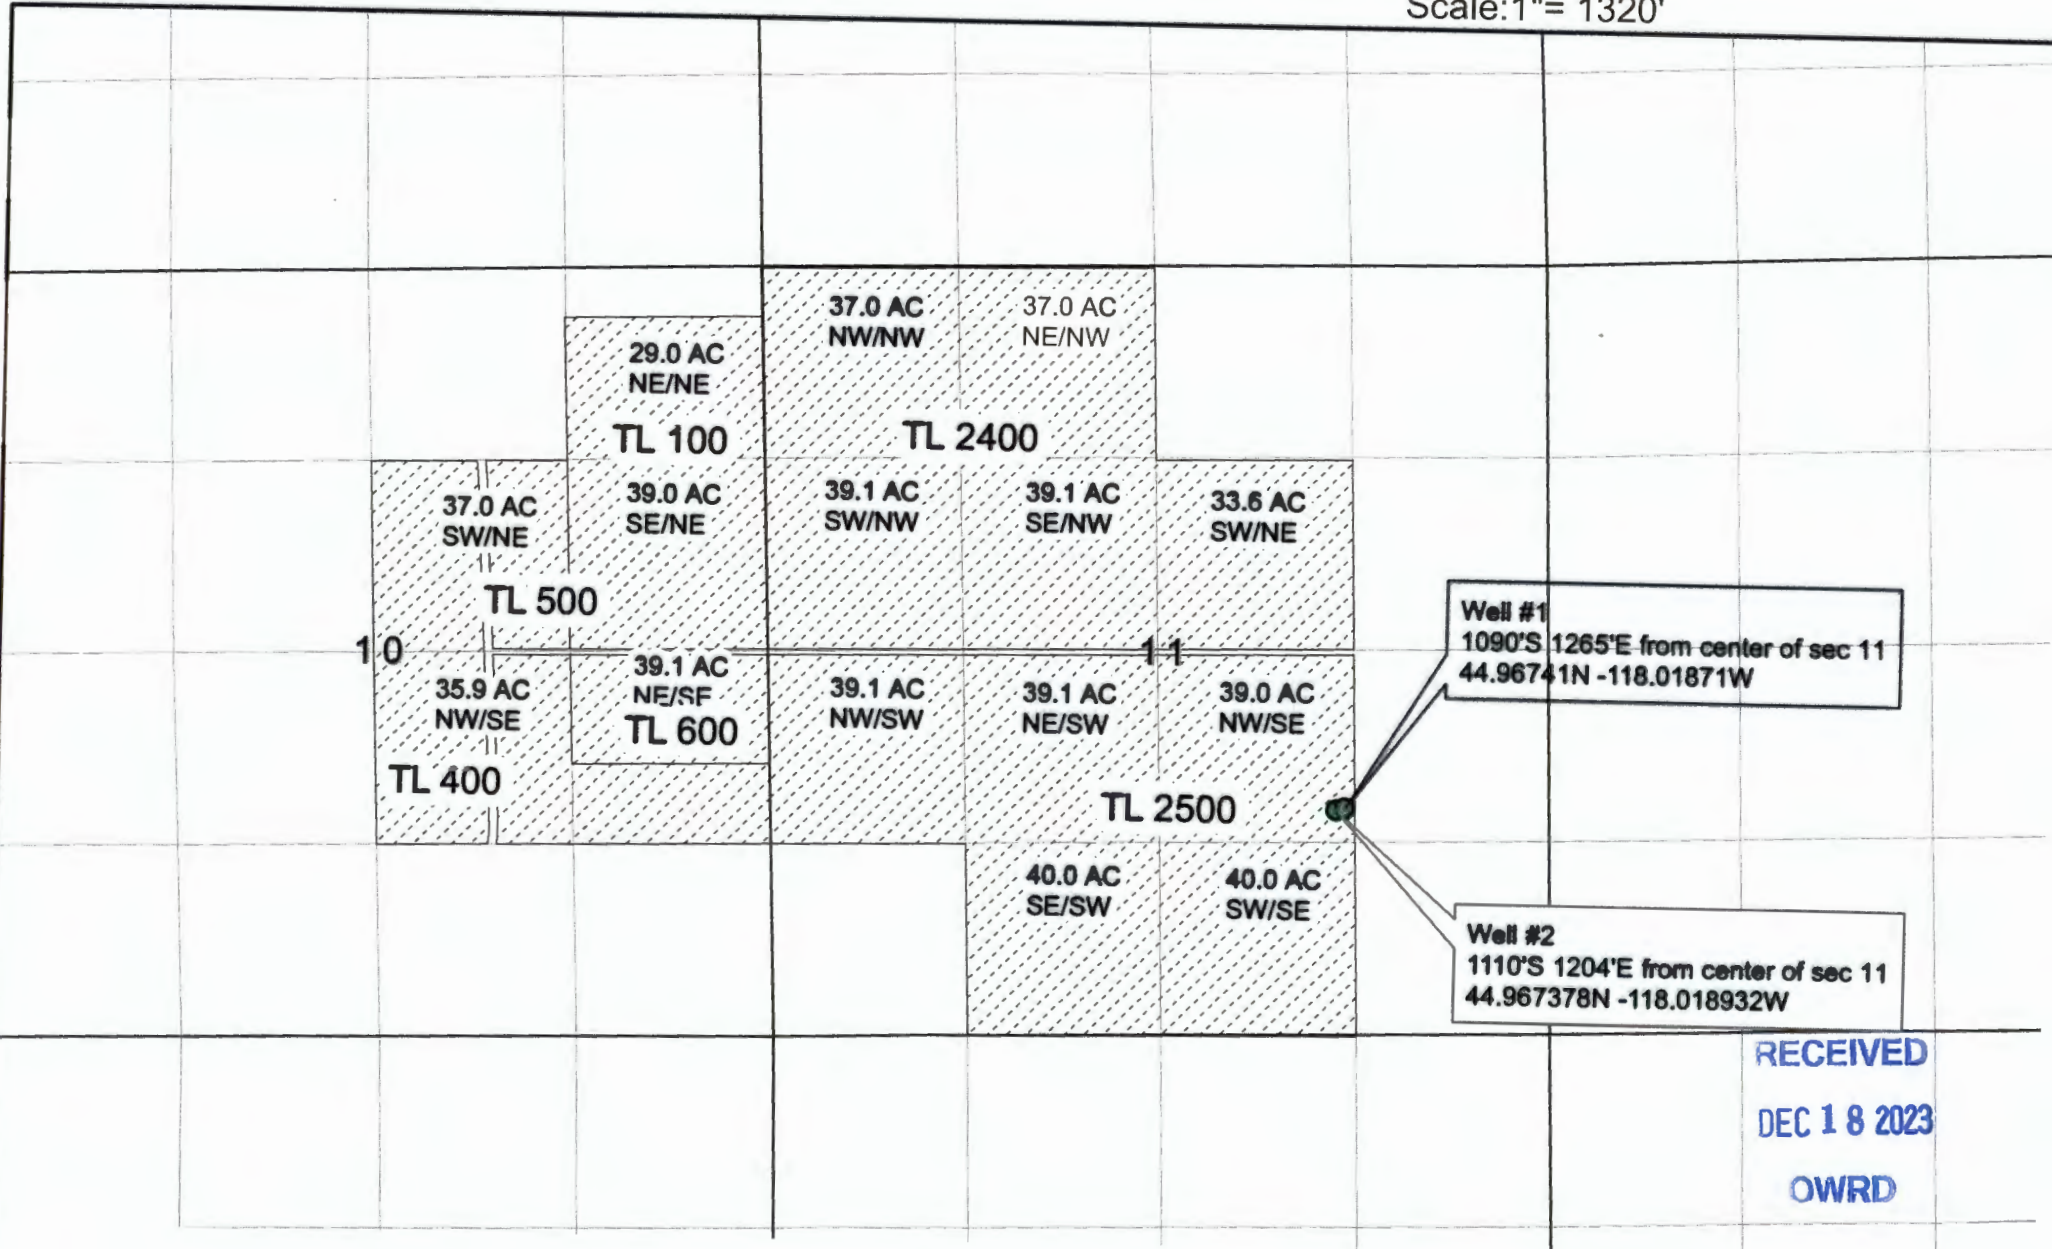

Well #1
1090'S 1265'E from center of sec 11
44.96741N -118.01871W

Well #2
1110'S 1204'E from center of sec 11
44.967378N -118.018932W

RECEIVED

DEC 18 2023

OWRD