

Application for Water Rights at Marial Lodge on The Rogue River

Located in Lots  
Section 9, T.33 S.,  
R. 10W., W. M.  
on federal land

My lease covers  
2.1 Acres


RECEIVED

DEC 12 1997

WATER RESOURCES DEPT.  
SALEM, OREGON

Application No. 83728  
Permit No. ✓

Scale 1" = 200'

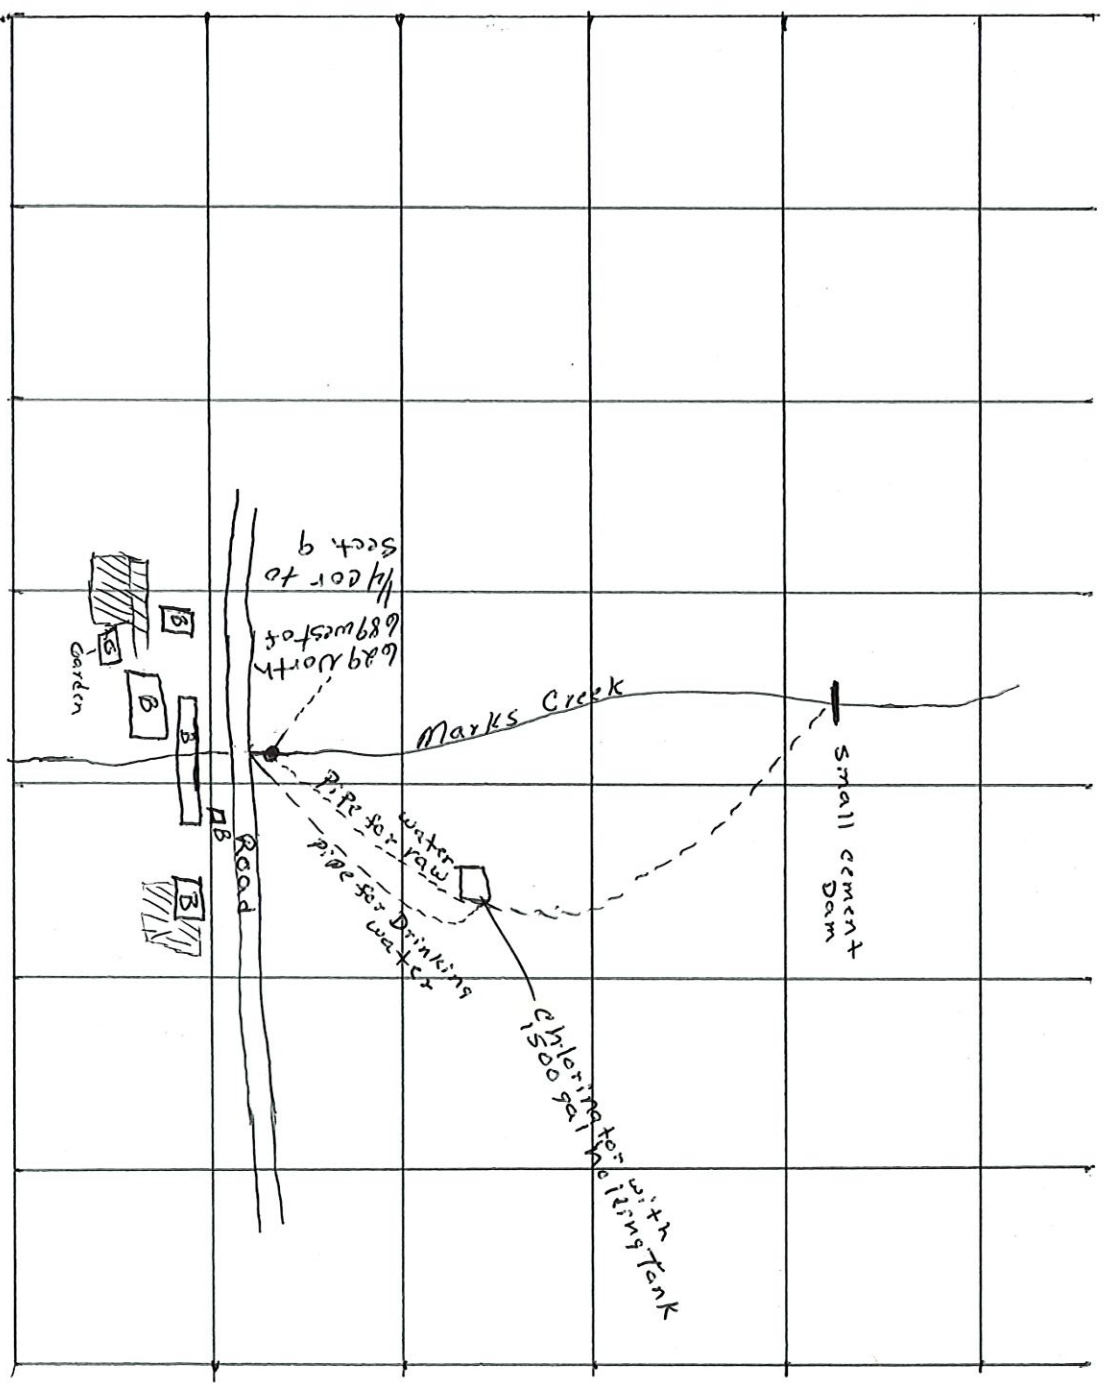

 Lawn Area  
 B = Building  
 G = Garden

