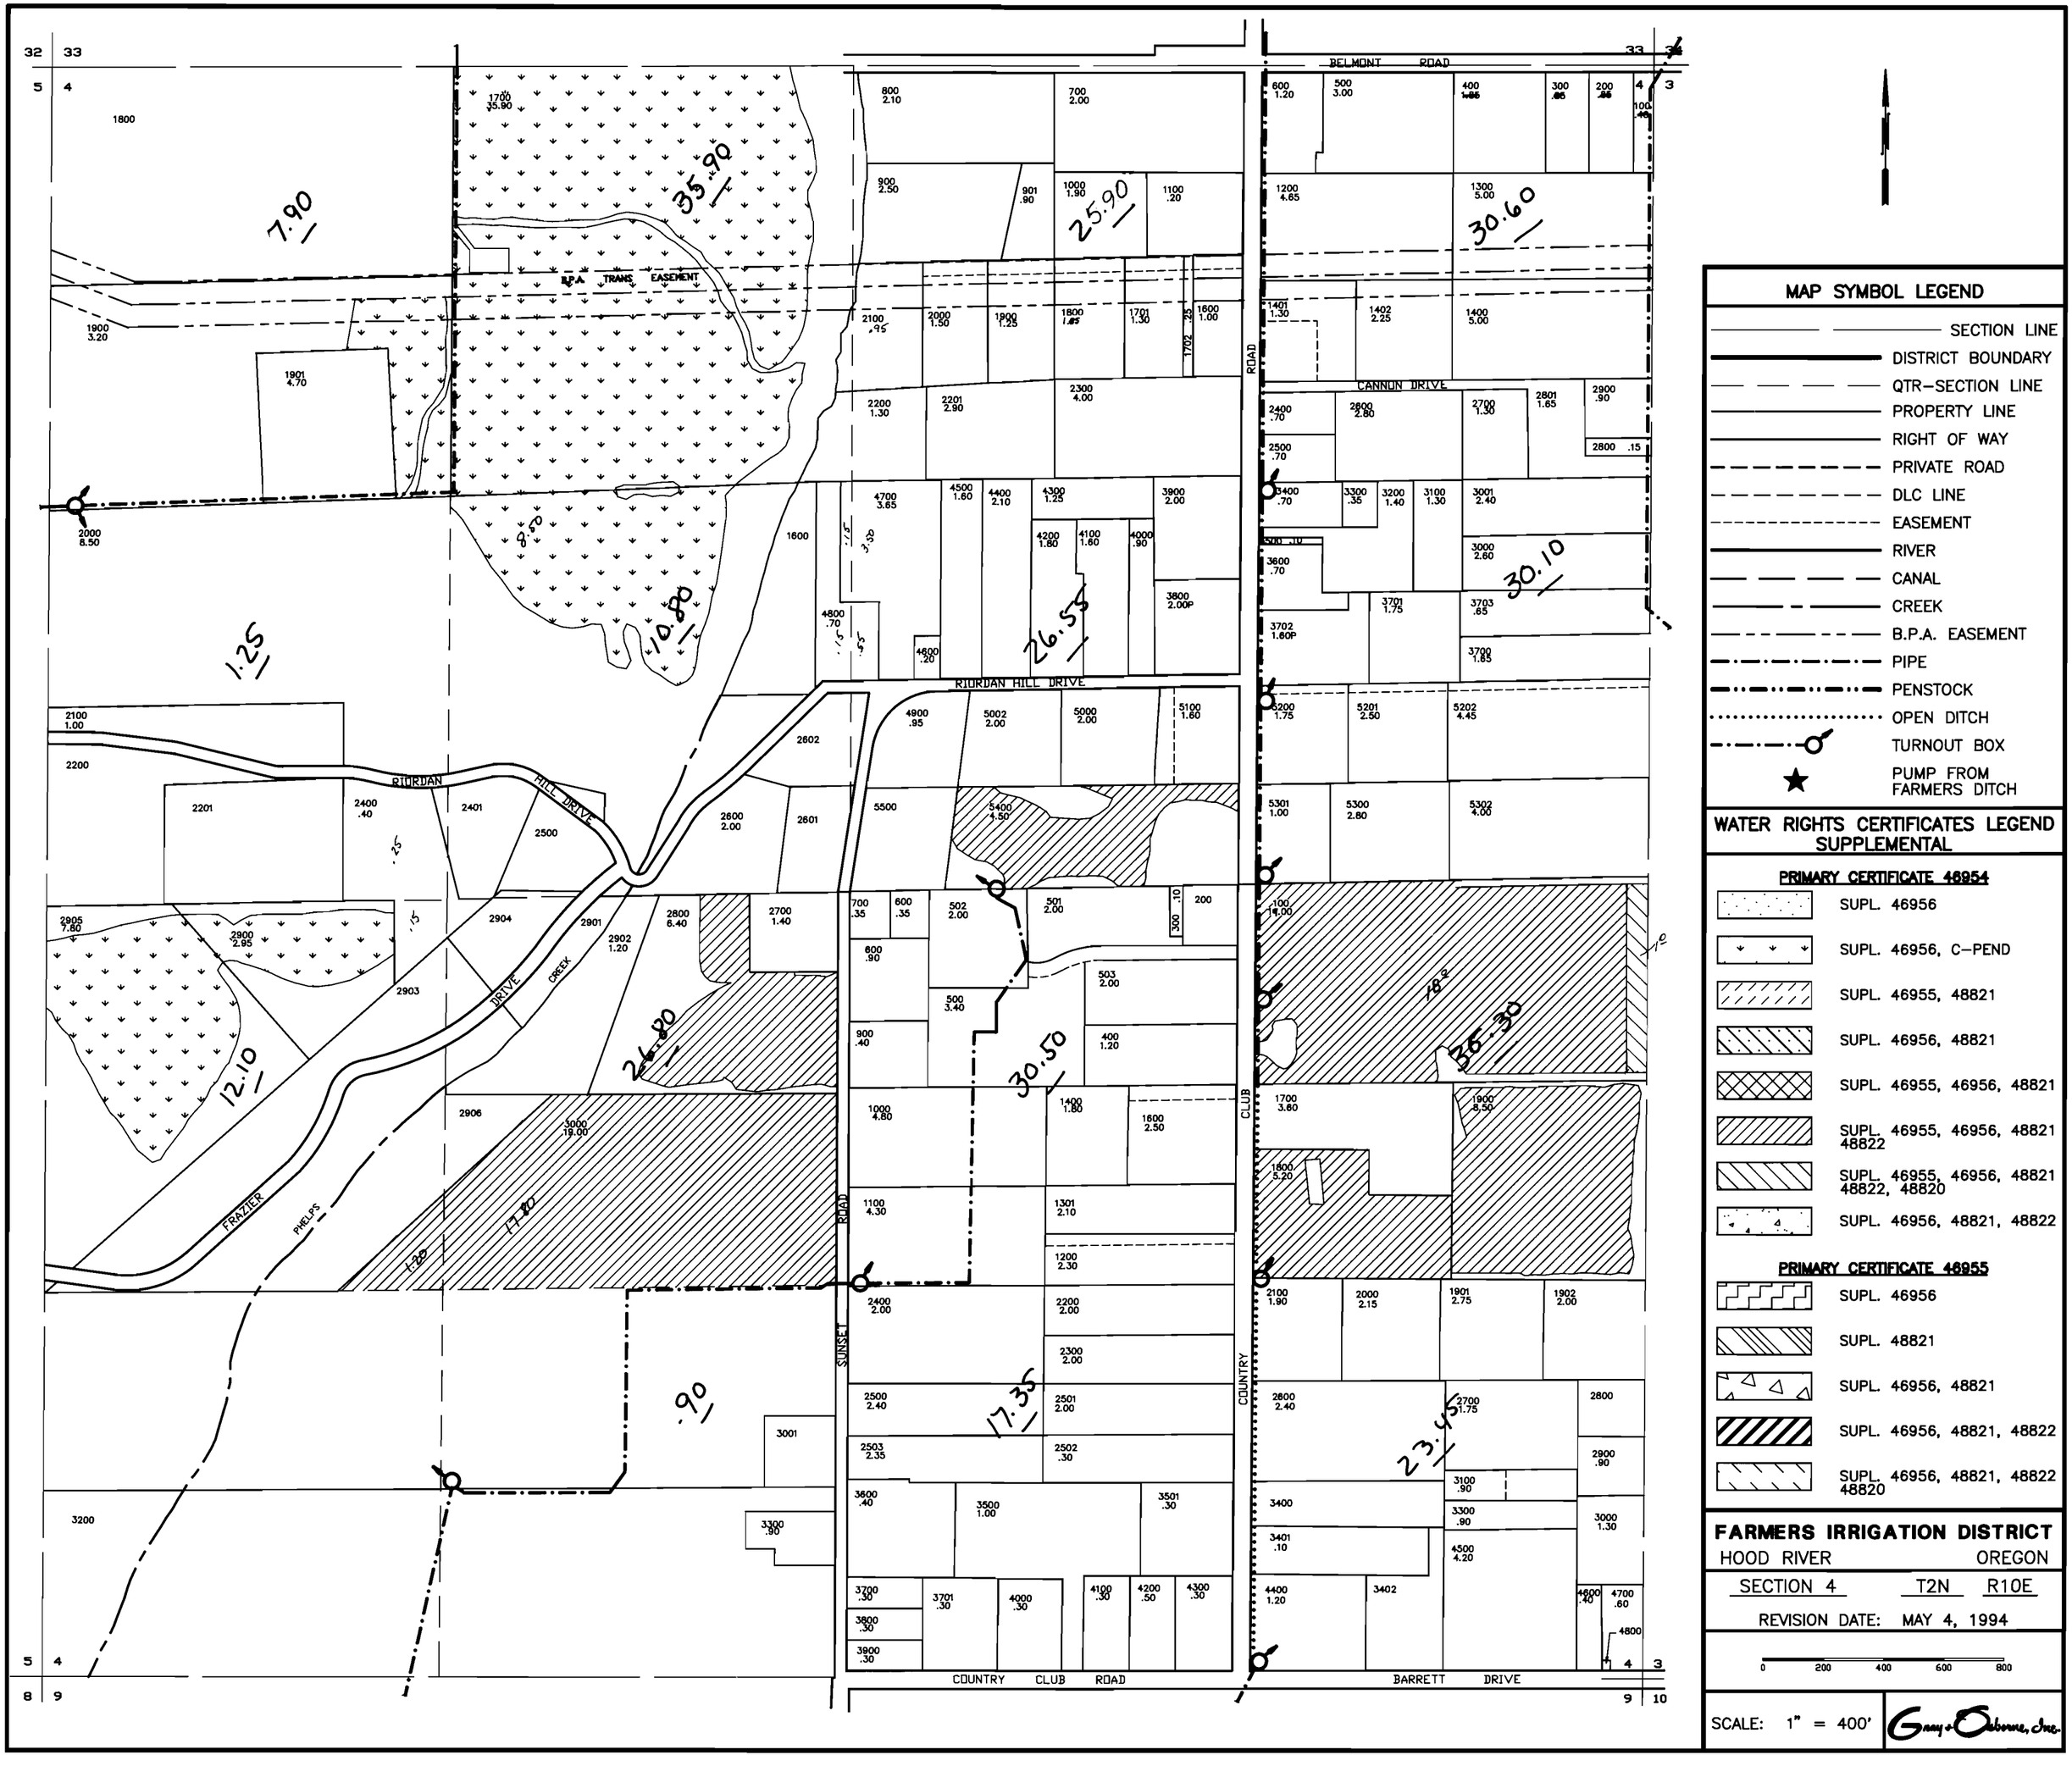
BELMONT ROAD
CANNON DRIVE
RIORDAN HILL DRIVE
RIORDAN HILL DRIVE
FRAZIER CREEK DRIVE
PHELPS
B.P.A. TRANS. EASEMENT
SUNSET ROAD
CLUB ROAD
COUNTRY CLUB ROAD
COUNTRY CLUB ROAD
BARRETT DRIVE
7.90
35.90
25.90
30.60
30.10
26.55
10.80
8.50
1.25
12.10
30.50
36.30
17.35
23.45
.90
17.80
1.20
.35
.15
.25
.30
.55
.15
.10
.15
.25
