


T. 29 S., R. 9 W., W.M., Section 23

**Diversion is:
1210 ft. South and
1315 ft. East of the
NW cor. Sec 23**

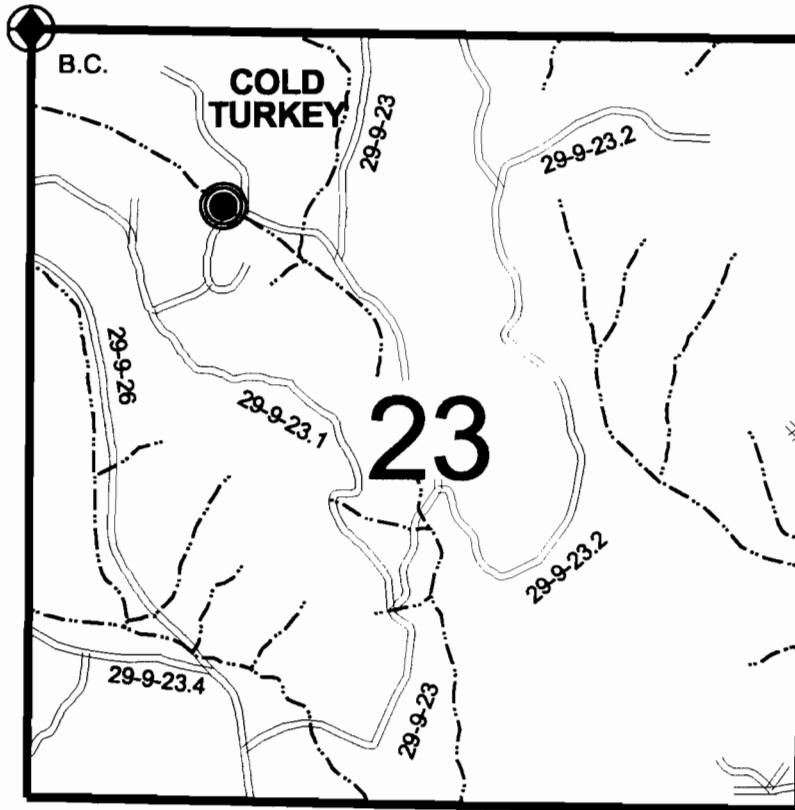

N
SCALE:
1" = 1320'

CLAIM OF BENEFICIAL USE MAP

in name of

UNITED STATES BUREAU OF LAND MANAGEMENT

Application No.: R - 70703

S - 70515

Permit No.: R - 11749

52481

RECEIVED

SEP 25 2000



Expires: 12/31/01


**WATER RESOURCES DEPT.
SALEM, OREGON**

SURVEYED: May 25, 2000

**THIS MAP WAS PREPARED FOR THE PURPOSE OF IDENTIFYING THE LOCATION OF A WATER RIGHT ONLY
AND IS NOT INTENDED TO PROVIDE LEGAL DIMENSIONS OR LOCATION OF PROPERTY OWNERSHIP LINES.**

**U.S. Bureau of Land Management
Roseburg District Office
Division of Operations**

**Executed by:
Karel M. Broda, PE, CWRE
777 N.W. Garden Valley Blvd.
Roseburg, Oregon 97470**

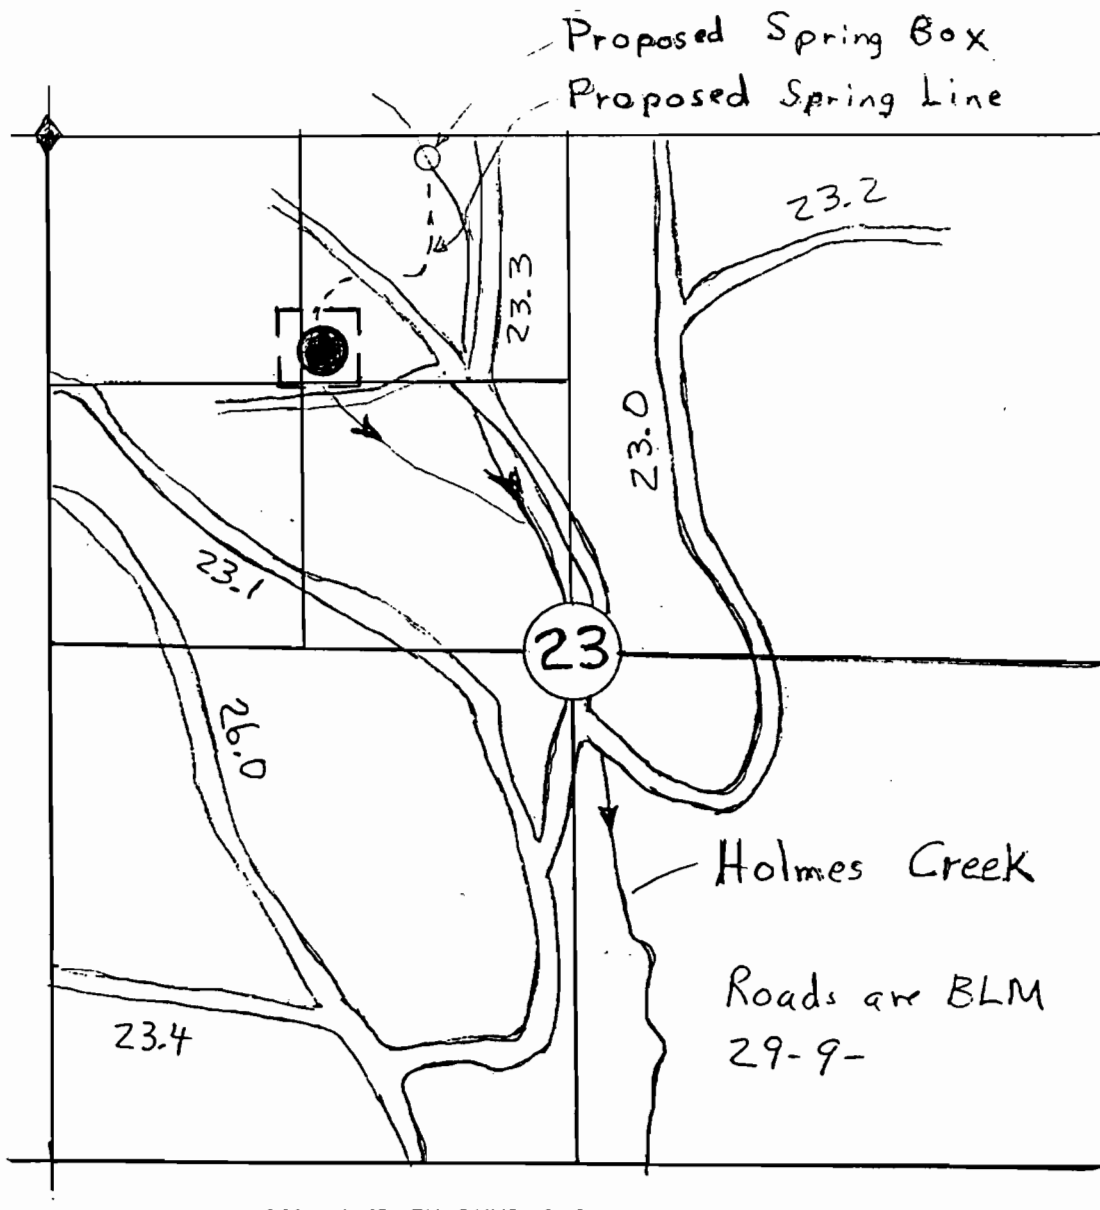


COLD TURKEY PUMP CHANCE
T29S R9W Sec 23
NE $\frac{1}{4}$, NW $\frac{1}{4}$

The proposed Spring box is to be located at 175 ft South and 1850 ft East from the Northwest Section corner of Section 23. The Pump Chance is located 1100 ft South and 1375 ft East from the Northwest Section corner of Section 23.

Coordinate Ties are based on aerial photo 2-3-19-89.

The map is shown for the purpose of water application and not property boundary.

Application No. 70515, R. 70703

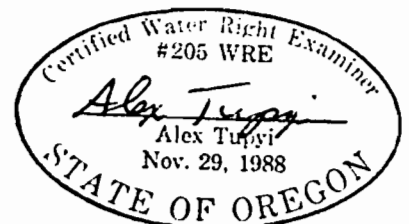

3-5-90