


T. 31 S., R. 9 W., W.M., Section 3

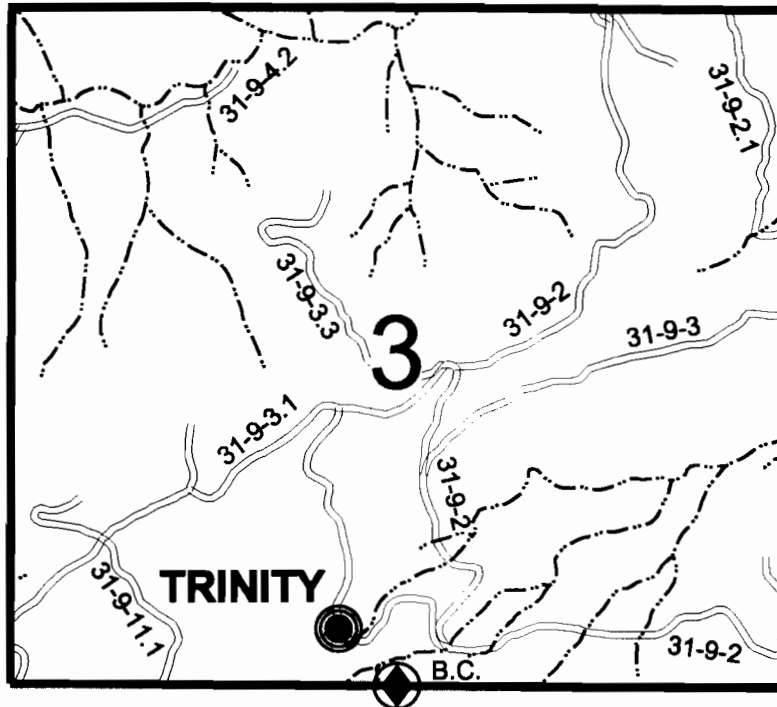

SCALE:
1" = 1320'



Diversion is:
397 ft. North and
397 ft. West of the
S 1/4 cor. Sec 3

CLAIM OF BENEFICIAL USE MAP

in name of


UNITED STATES BUREAU OF LAND MANAGEMENT

Application No.: R - 70704

S - 70516

Permit No.: R - 11763

52113

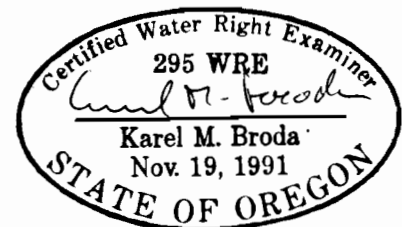

Expires: 12/31/01

SURVEYED: June 14, 2000

THIS MAP WAS PREPARED FOR THE PUPOSE OF IDENTIFYING THE LOCATION OF A WATER RIGHT ONLY
AND IS NOT INTENDED TO PROVIDE LEGAL DIMENSIONS OR LOCATION OF PROPERTY OWNERSHIP LINES.

U.S. Bureau of Land Management
Roseburg District Office
Division of Operations


Executed by:
Karel M. Broda, PE, CWRE
777 N.W. Garden Valley Blvd.
Roseburg, Oregon 97470

RECEIVED

SEP 25 2000

WATER RESOURCES DEPT.
SALEM, OREGON

FINAL PROOF MAP

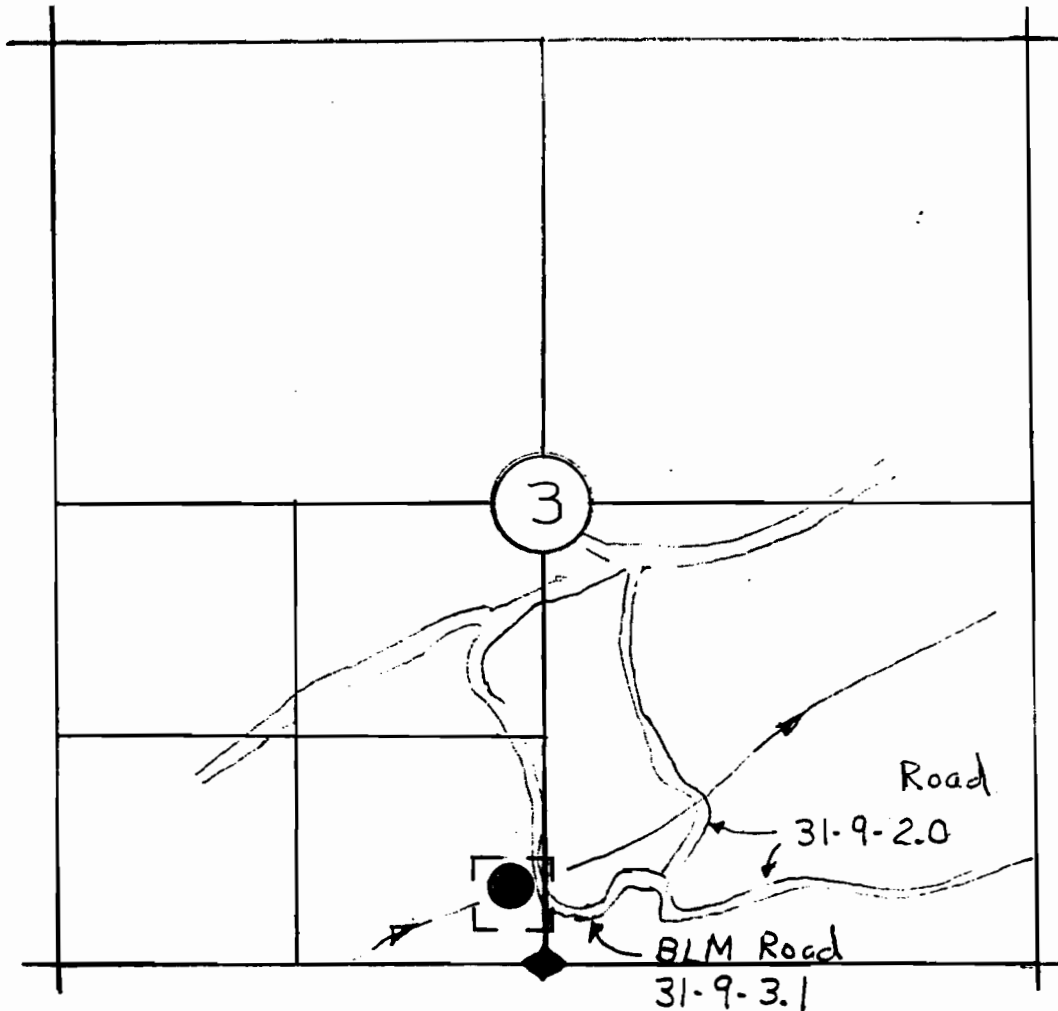

Scale 1" = 1000'


TRINITY PUMP CHANCE
T31S R9W Sec 3
SE $\frac{1}{4}$ SW $\frac{1}{4}$

The point of diversion is located 400 ft North and 150 ft West from the South Quarter Corner of Section 3.

Coordinate Ties are based on aerial photo 2-2-6-89.

The map is shown for the purpose of water application and not property boundary.

Application No. 70516, R. 70704
Permit No.

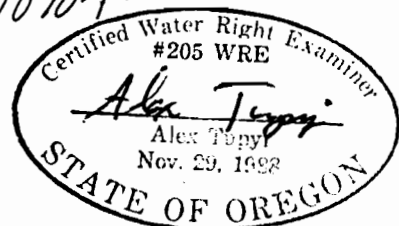

3-5-90