


T. 31 S., R. 9 W., W.M., Section 3

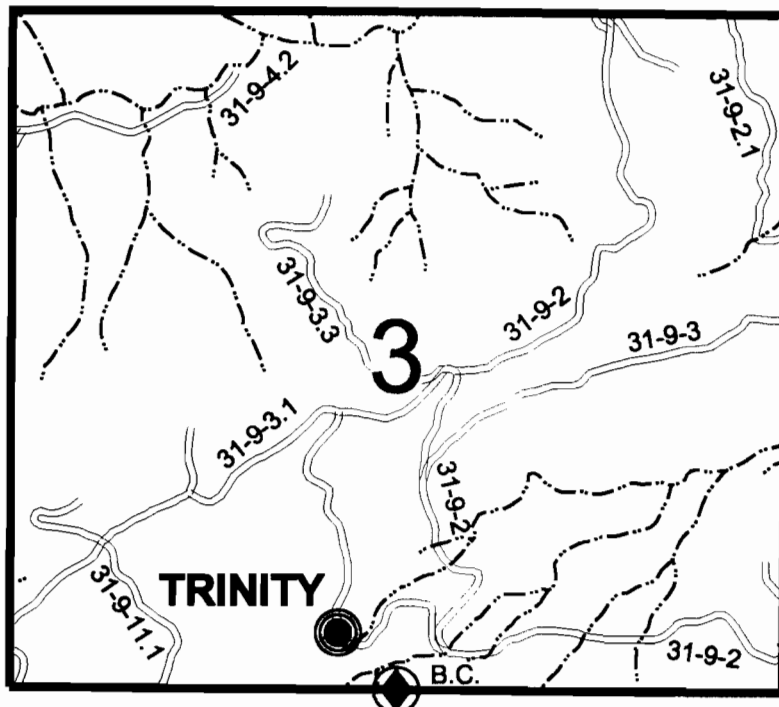

SCALE:
1" = 1320'



Diversion is:
397 ft. North and
397 ft. West of the
S 1/4 cor. Sec 3

CLAIM OF BENEFICIAL USE MAP

in name of


UNITED STATES BUREAU OF LAND MANAGEMENT

Application No.: R - 70704

S - 70516

Permit No.: R - 11763

52113

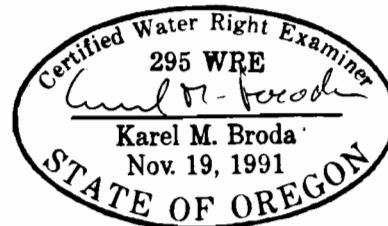

Expires: 12/31/01

SURVEYED: June 14, 2000

THIS MAP WAS PREPARED FOR THE PUPOSE OF IDENTIFYING THE LOCATION OF A WATER RIGHT ONLY
AND IS NOT INTENDED TO PROVIDE LEGAL DIMENSIONS OR LOCATION OF PROPERTY OWNERSHIP LINES.

U.S. Bureau of Land Management
Roseburg District Office
Division of Operations


Executed by:
Karel M. Broda, PE, CWRE
777 N.W. Garden Valley Blvd.
Roseburg, Oregon 97470

RECEIVED

SEP 25 2000

WATER RESOURCES DEPT.
SALEM, OREGON

FINAL PROOF MAP

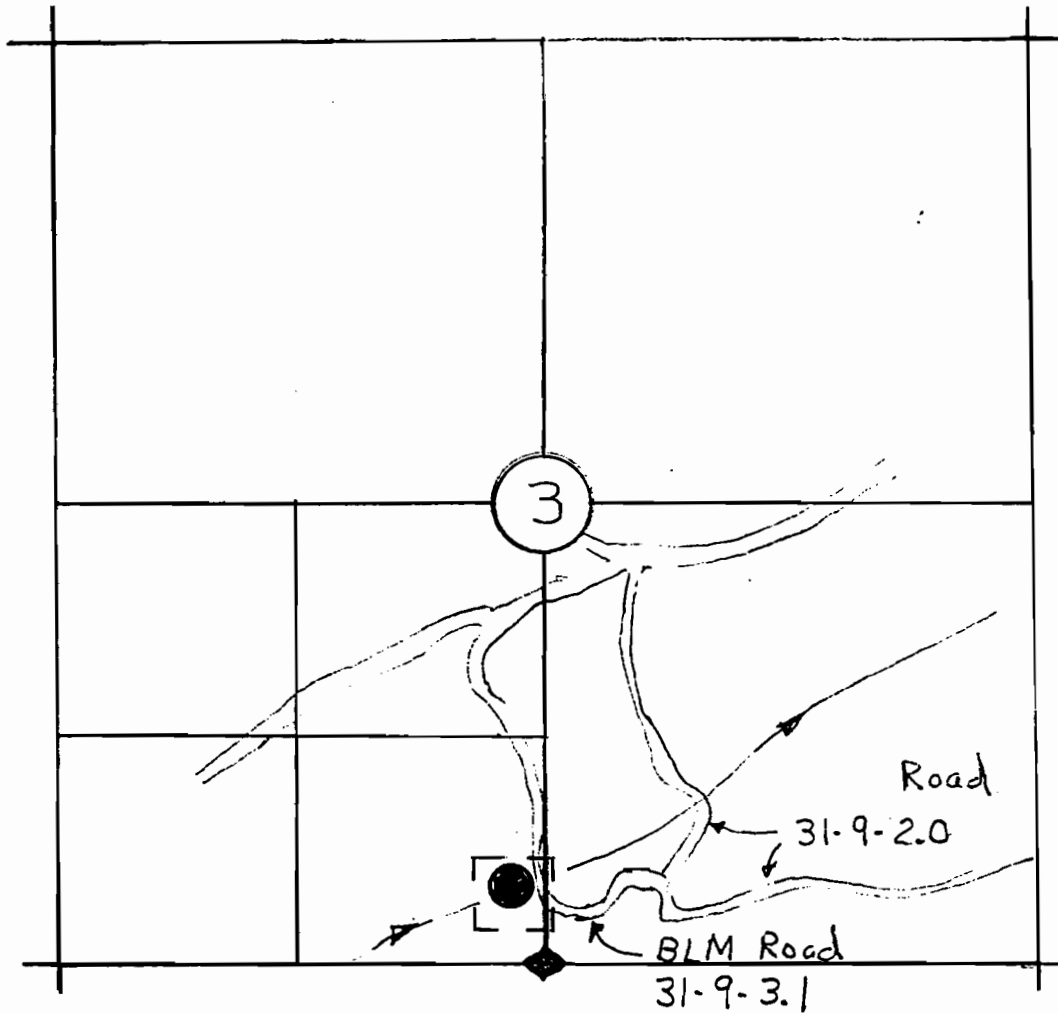


TRINITY PUMP CHANCE
T31S R9W Sec 3
SE $\frac{1}{4}$ SW $\frac{1}{4}$

The point of diversion is located 400 ft North and 150 ft West from the South Quarter Corner of Section 3.

Coordinate Ties are based on aerial photo 2-2-6-89.

The map is shown for the purpose of water application and not property boundary.

Application No. 70516, R. 70704
Permit No.

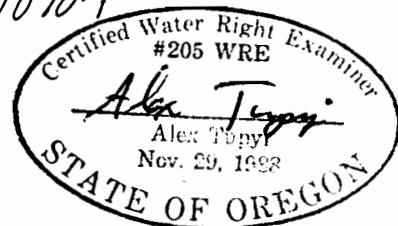

3-5-90