T. 29 S., R. 8 W., W.M., Section 5

RECEIVED

MAY 2 4 2000

WATER RESOURCES DEPT.
SALEM, OREGON

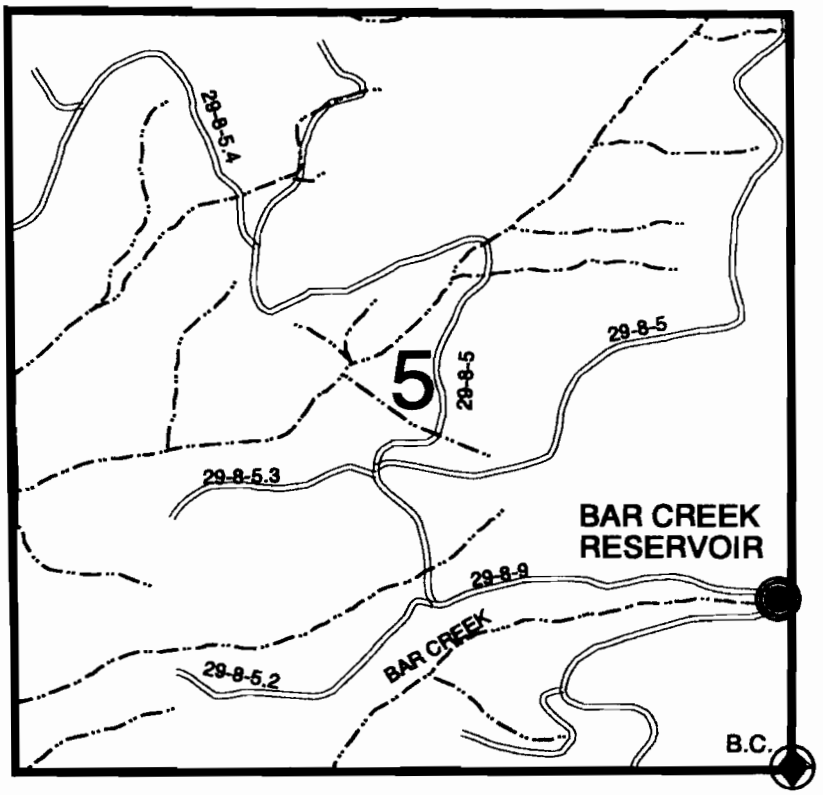

N

SCALE:
1" = 1320'

Diversion is:
1178 ft. North and
95 ft. West of the
SE cor. Sec. 5

CLAIM OF BENEFICIAL USE MAP

in name of

UNITED STATES BUREAU OF LAND MANAGEMENT

Application No.: R - 70706
S - 70522

Permit No.: R - 11882
52479

Certified Water Right Examiner
295 WRE
Karel M. Broda
Nov. 19, 1991
STATE OF OREGON

Expires: 12/31/01

SURVEYED: April 4, 2000

THIS MAP WAS PREPARED FOR THE PURPOSE OF IDENTIFYING THE LOCATION OF A WATER RIGHT ONLY AND IS NOT INTENDED TO PROVIDE LEGAL DIMENSIONS OR LOCATION OF PROPERTY OWNERSHIP LINES.

U.S. Bureau of Land Management Roseburg District Office Division of Operations	Executed by: Karel M. Broda, PE, CWRE 777 N.W. Garden Valley Blvd. Roseburg, Oregon 97470

FINAL PROOF MAP

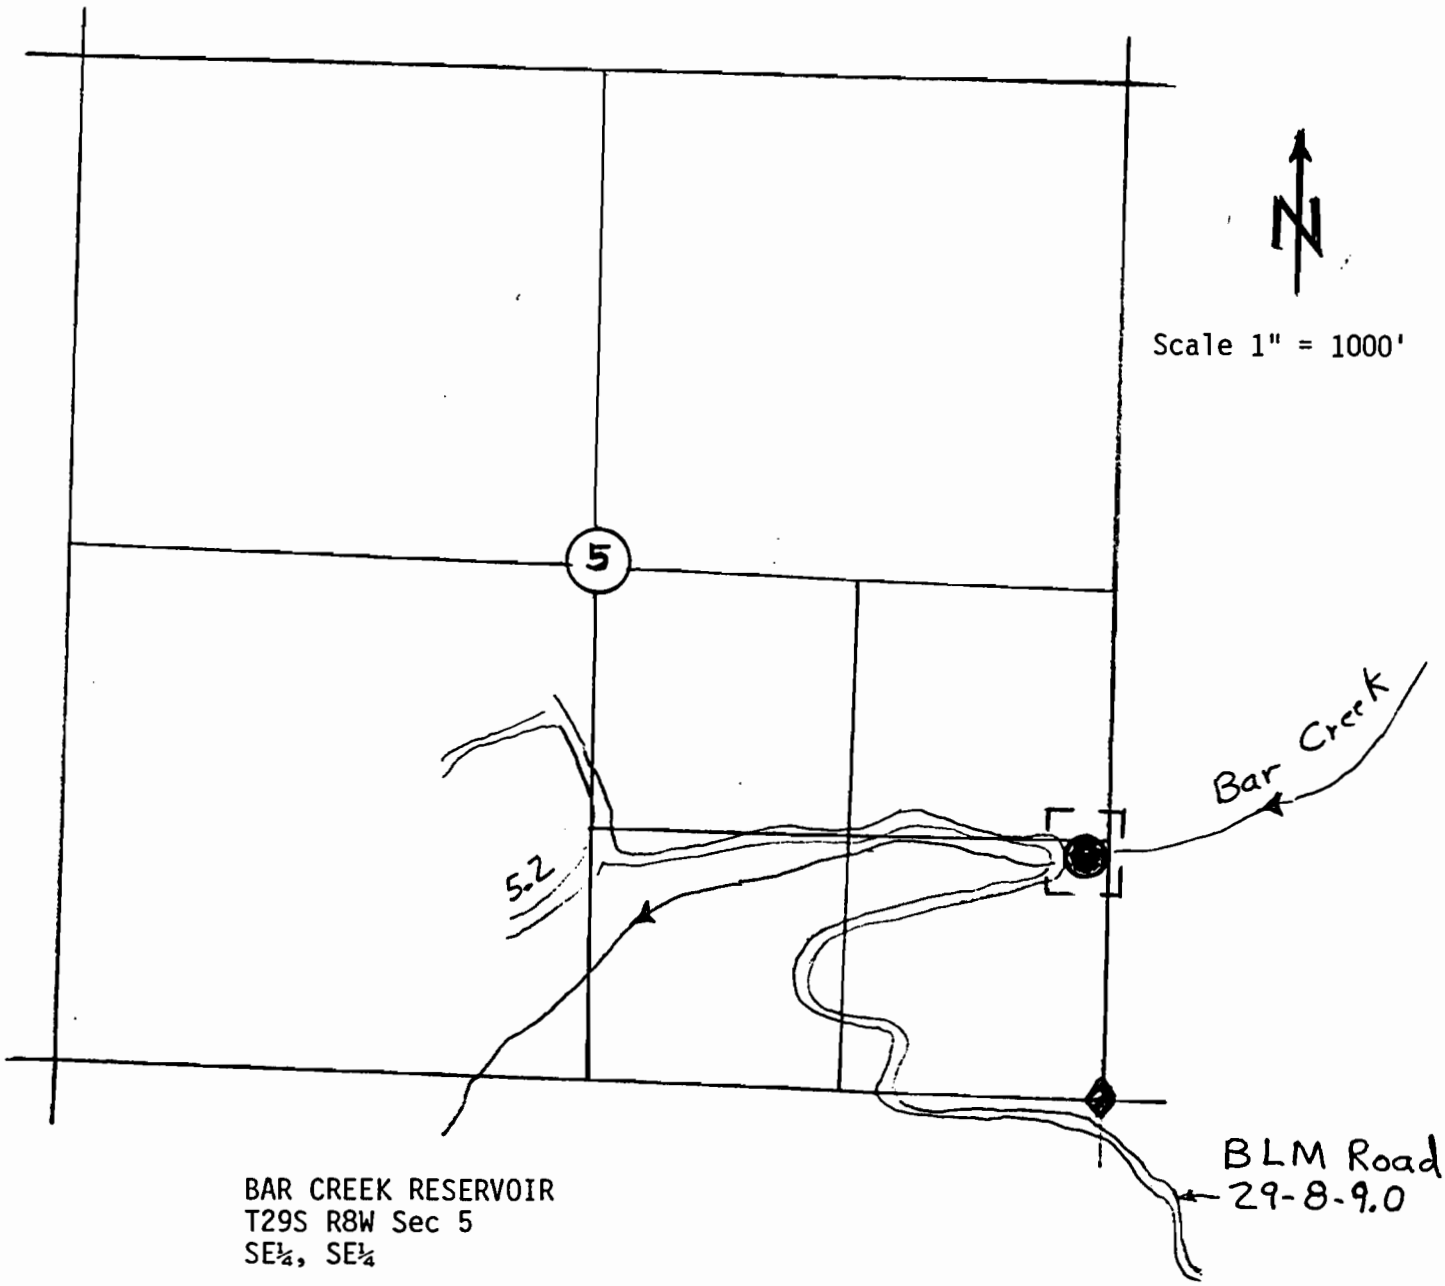

BAR CREEK RESERVOIR
T29S R8W Sec 5
SE¼, SE¼

The point of diversion is located 1200 ft North and 200 ft West from the Southeast Section Corner of Section 5.

Coordinate Ties are based on aerial photo. 2-6-37-89

The map is shown for the purpose of water application and not property boundary.

Application No. 70522, R. 70706
Permit No. [illegible]

Certified Water Right Examiner
#205 WRE
Alex Tupyi
Nov. 29, 1988
STATE OF OREGON

3-5-90