


T. 30 S., R. 8 W., W.M., Section 27

Diversion is:
676 ft. South and
1125 ft. East of the
NW cor. Sec 27

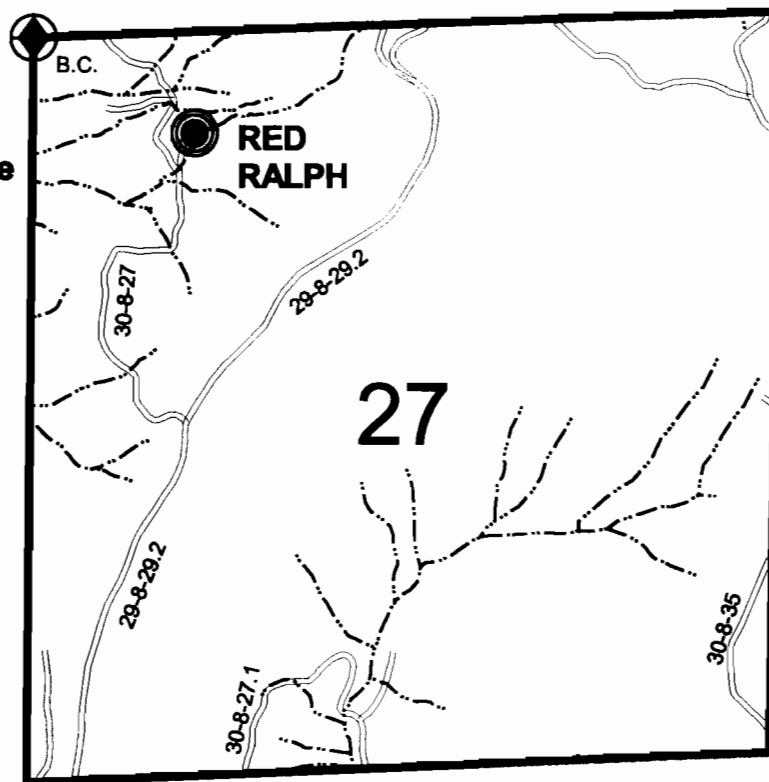

N
SCALE:
1" = 1320'

CLAIM OF BENEFICIAL USE MAP

in name of

UNITED STATES BUREAU OF LAND MANAGEMENT

Application No.: R - 70707

S - 70523


Permit No.: R - 11883

52478

RECEIVED

SEP 25 2000

WATER RESOURCES DEPT.
SALEM, OREGON

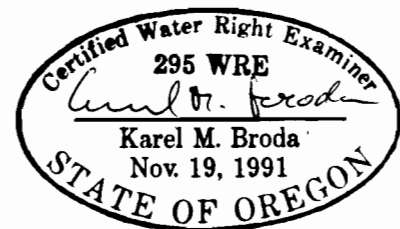

Expires: 12/31/01


SURVEYED: May 10, 2000

THIS MAP WAS PREPARED FOR THE PURPOSE OF IDENTIFYING THE LOCATION OF A WATER RIGHT ONLY
AND IS NOT INTENDED TO PROVIDE LEGAL DIMENSIONS OR LOCATION OF PROPERTY OWNERSHIP LINES.

U.S. Bureau of Land Management
Roseburg District Office
Division of Operations

Executed by:
Karel M. Broda, PE, CWRE
777 N.W. Garden Valley Blvd.
Roseburg, Oregon 97470

FINAL PROOF MAP

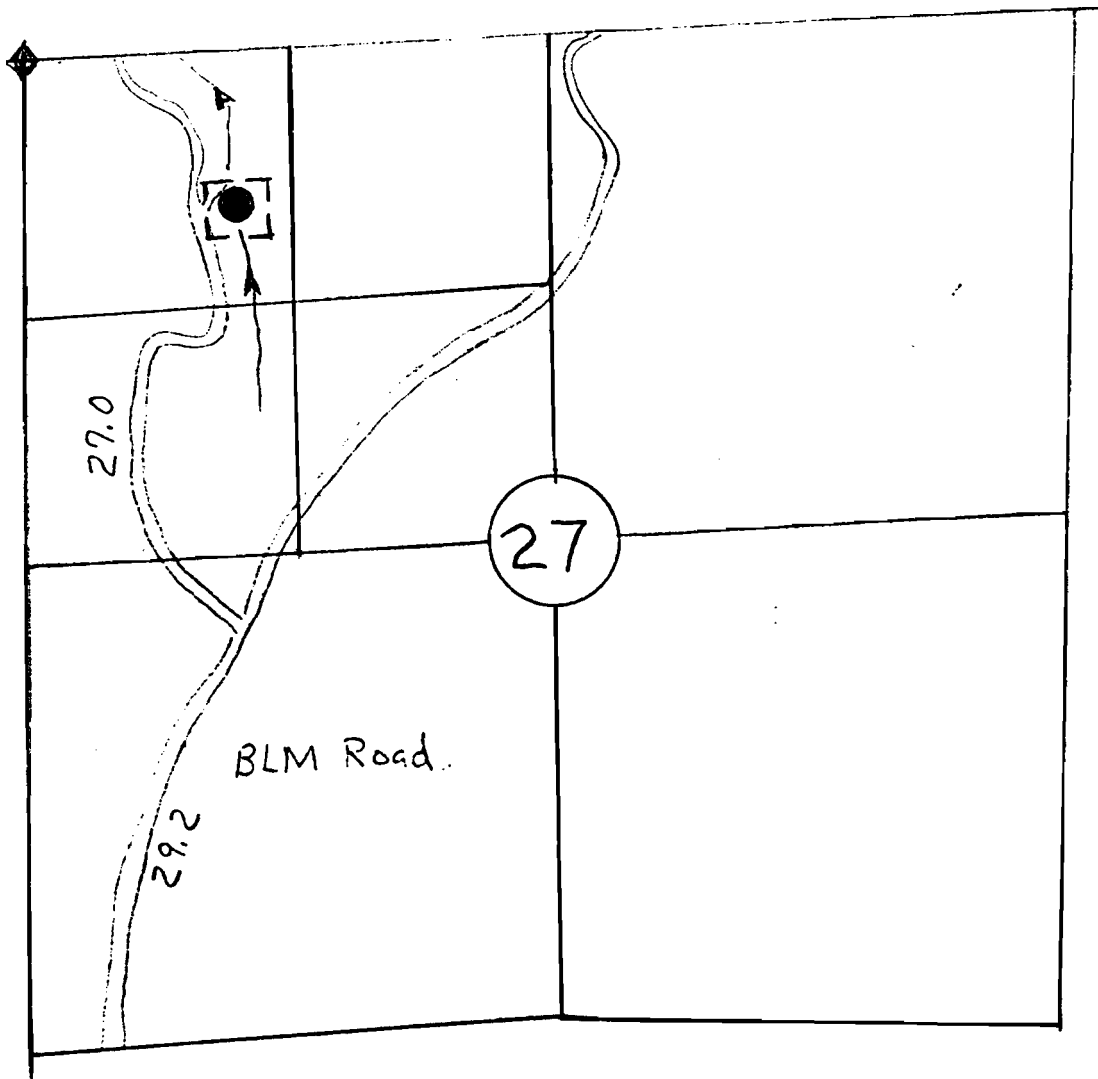

Scale 1" = 1000'


RED RALPH PUMP CHANCE
T30S R8W Sec 27
NW $\frac{1}{4}$ NW $\frac{1}{4}$

The point of diversion is located 750 ft South and 1100 ft East from the Northwest Section Corner of Section 27.

Coordinate Ties are based on aerial photo 3- 8-18-89.

The map is shown for the purpose of water application and not property boundary.

APPLICATION: 70523, R.70707
PERMIT: R11883

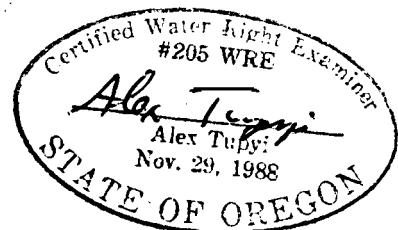

3-5-90