


T.1S.,R.12E.,WM.

Original field forms & map in file 57562

Copy

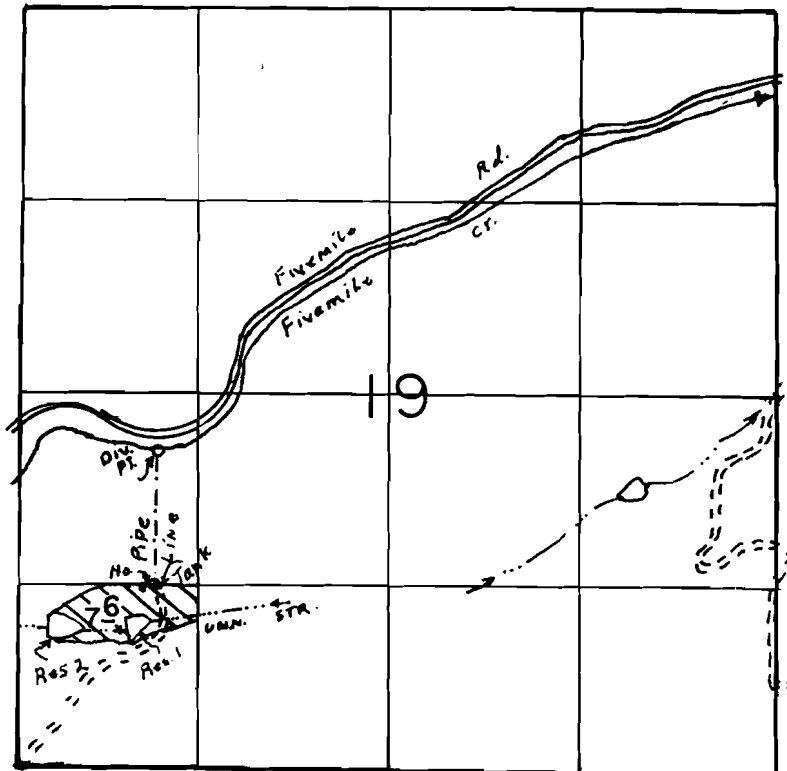

DIV. PT. LOC: 2180' N & 950' E FROM SW COR. OF SEC. 19.
 DAMS 1 & 2 LOC: IN SW 1/4, SW 1/4 OF SEC 19.

SCALE: 1" = 1320'

FINAL PROOF SURVEY
 UNDER

Application No. R-57562 Permit No. R-43874
 R-57561 R-7790...
 IN NAME OF

DENNIS D. TRIBBY

Surveyed JUNE 26 1995, by R.M. SUTTERFIELD