
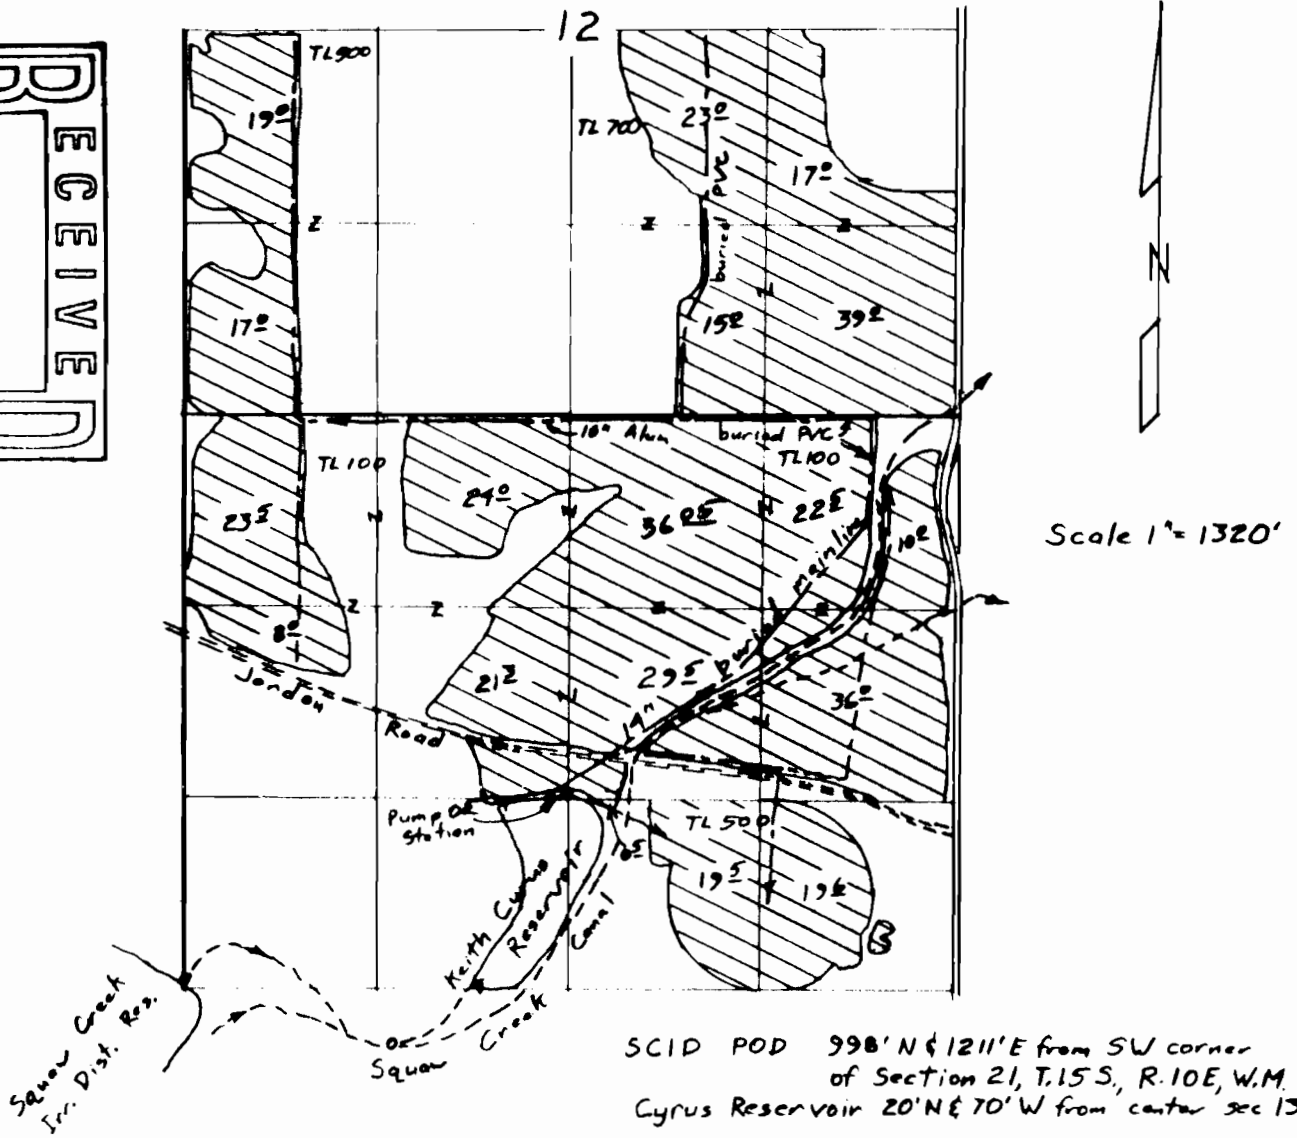


TOWNSHIP 15 SOUTH, RANGE 10 EAST, W.M.

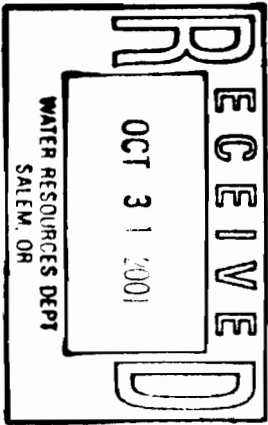


SCID POD 998' N & 1211' E from SW corner of Section 21, T.15S, R.10E, W.M. Cyrus Reservoir 20' N & 70' W from center sec 13

Surveyed Feb 12, 2001

Claim of Beneficial Use Map  
for  
**KEITH CYRUS**

App R-69830 & S-69831  
Per R-12074 & 52916

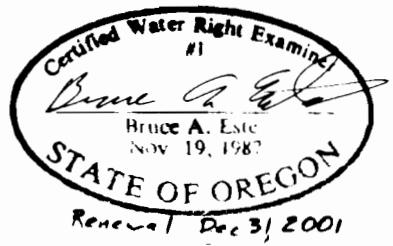

This map is for the purpose of locating a water right only and has no intent to provide legal dimensions or the location of property lines.

**ESTES SURVEYS, LLC**  
 PO Box 17519 60382 Arnold Rd  
 Salem, OR 97305-7519 Bend, OR 97702  
 (503) 585-7593 (541) 382-7391