


T. 26 S., R. 3 W., W.M.

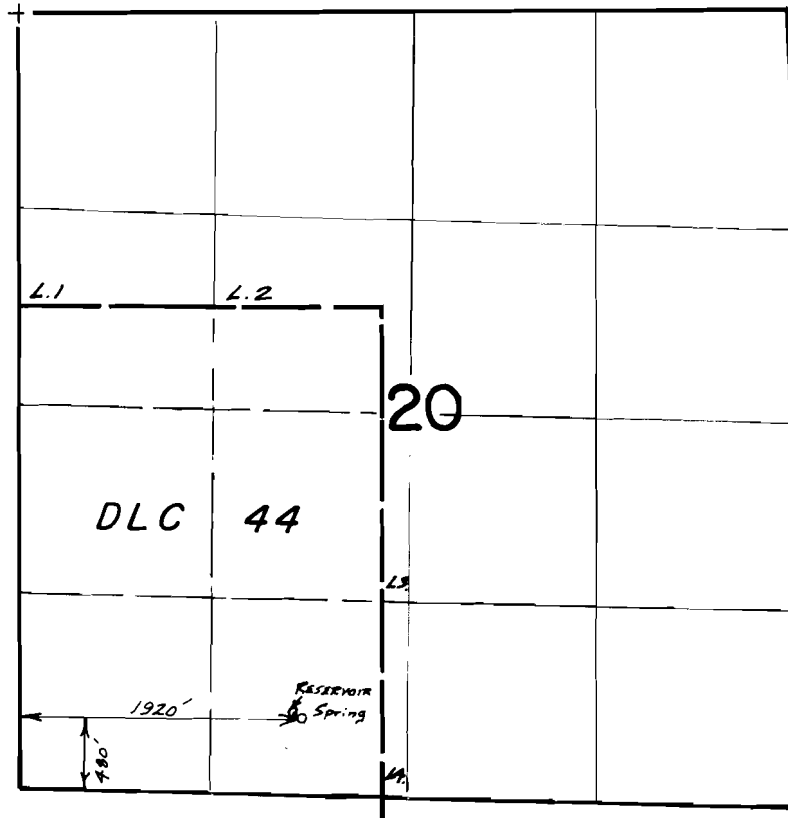

Scale : 1"=1320'

FINAL PROOF SURVEY
UNDER

R-58850 R-7997
Application No. 58851. Permit No. 44695....
IN NAME OF

.....Frances..M.(Manning)..Livingston...

Surveyed Oct..22, 1991.., by B.S.James.....