


T.20S., R.3W., W.M.

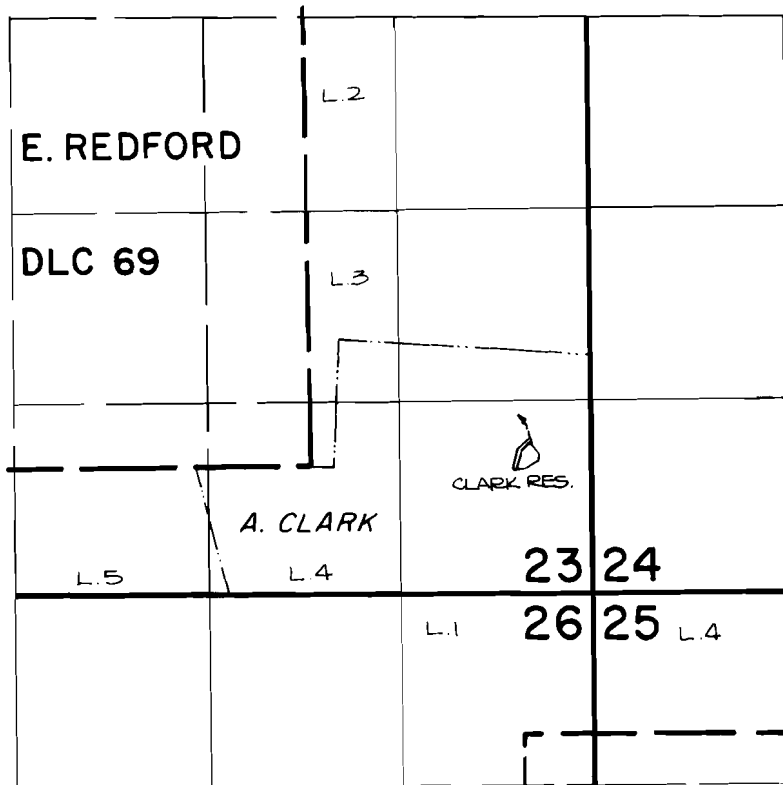

THE DIV. PT. IS LOCATED 970 FT. N. AND 460 FT. W. FROM
THE S.E. CORNER OF SECTION 23.



FINAL PROOF SURVEY
UNDER

SCALE: 4"=1 MILE

Application No. R-~~58854~~ Permit No. R-7990
IN NAME OF

ANDREW J. CLARK

Surveyed SEPT. 24, 1984, by *P. Patten*