

T 2 N, R 10 E, WM

SEC 2

2


UNNAMED STREAM
TRIBUTARY OF INDIAN CK

RESERVOIR #4
AREA 0.76 ACRES
7.39 AC FT
MAX DEPTH 13 FT

RESERVOIR #1
AREA 0.06 ACRES
0.10 AC FT
MAX DEPTH 4 FT

RESERVOIR #2
AREA 0.41 ACRES
2.39 AC FT
MAX DEPTH 7 FT

RESERVOIR #3
AREA 0.20 ACRES
0.20 AC FT
MAX DEPTH 6 FT

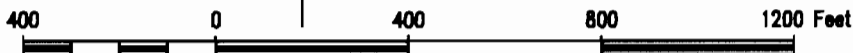

INDIAN CK ROAD

CERTIFICATE:

I, ANTHONY C. KLEIN, THE WITHIN REGISTERED WATER RIGHT EXAMINER DO HEREBY CERTIFY THAT THIS MAP WAS PREPARED BY ME AND IS FOR THE PURPOSE OF IDENTIFYING THE LOCATION OF THE WATER RIGHT ONLY AND HAS NO INTENT TO PROVIDE DIMENSIONS OR LOCATION OF PROPERTY OWNERSHIP LINES.


FINAL PROOF SURVEY

UNDER

APPLICATION NO. R-70013, PERMIT NO. R-11190
IN NAME OF

BROOKSIDE INC.

SURVEYED APRIL 1993

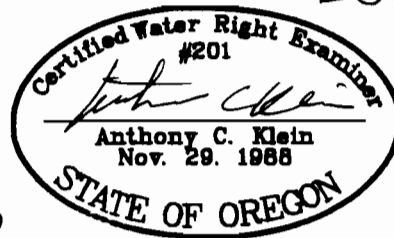

Klein & Assoc.

LAND SURVEYING
1109 Country Club Road
Hood River, Oregon 97031
Tele: (503)386-3322
JOB NO. 93021