



T. 7 N., R. 3 W., W. M.

SECTION 8

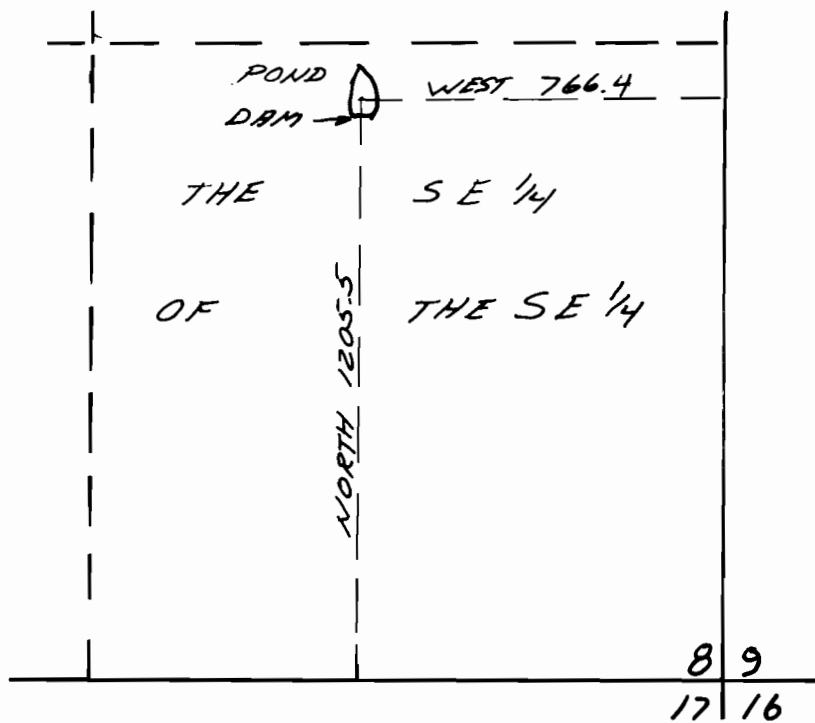

SCALE
1" = 400'

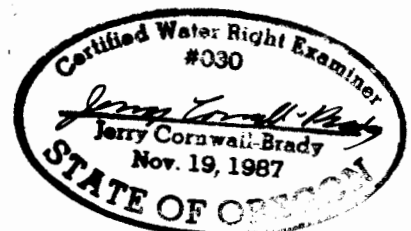

RENEWAL DATE 12-31-95

FINAL PROOF SURVEY
UNDER

PERMIT NO. R-11258

IN THE NAME OF RONALD TATE

SURVEYED SEPT. 13, 1994 BY JERRY CORNWALL-BRADY