


BRUCE AND CLAUDETTE PHILLIPS

P.O. BOX 47
OREGON CITY, OREGON 97045

SOUTHWEST QUARTER, SECTION 28,
TOWNSHIP 3 SOUTH, RANGE 2 EAST, W.M.,
CLACKAMAS COUNTY, OREGON

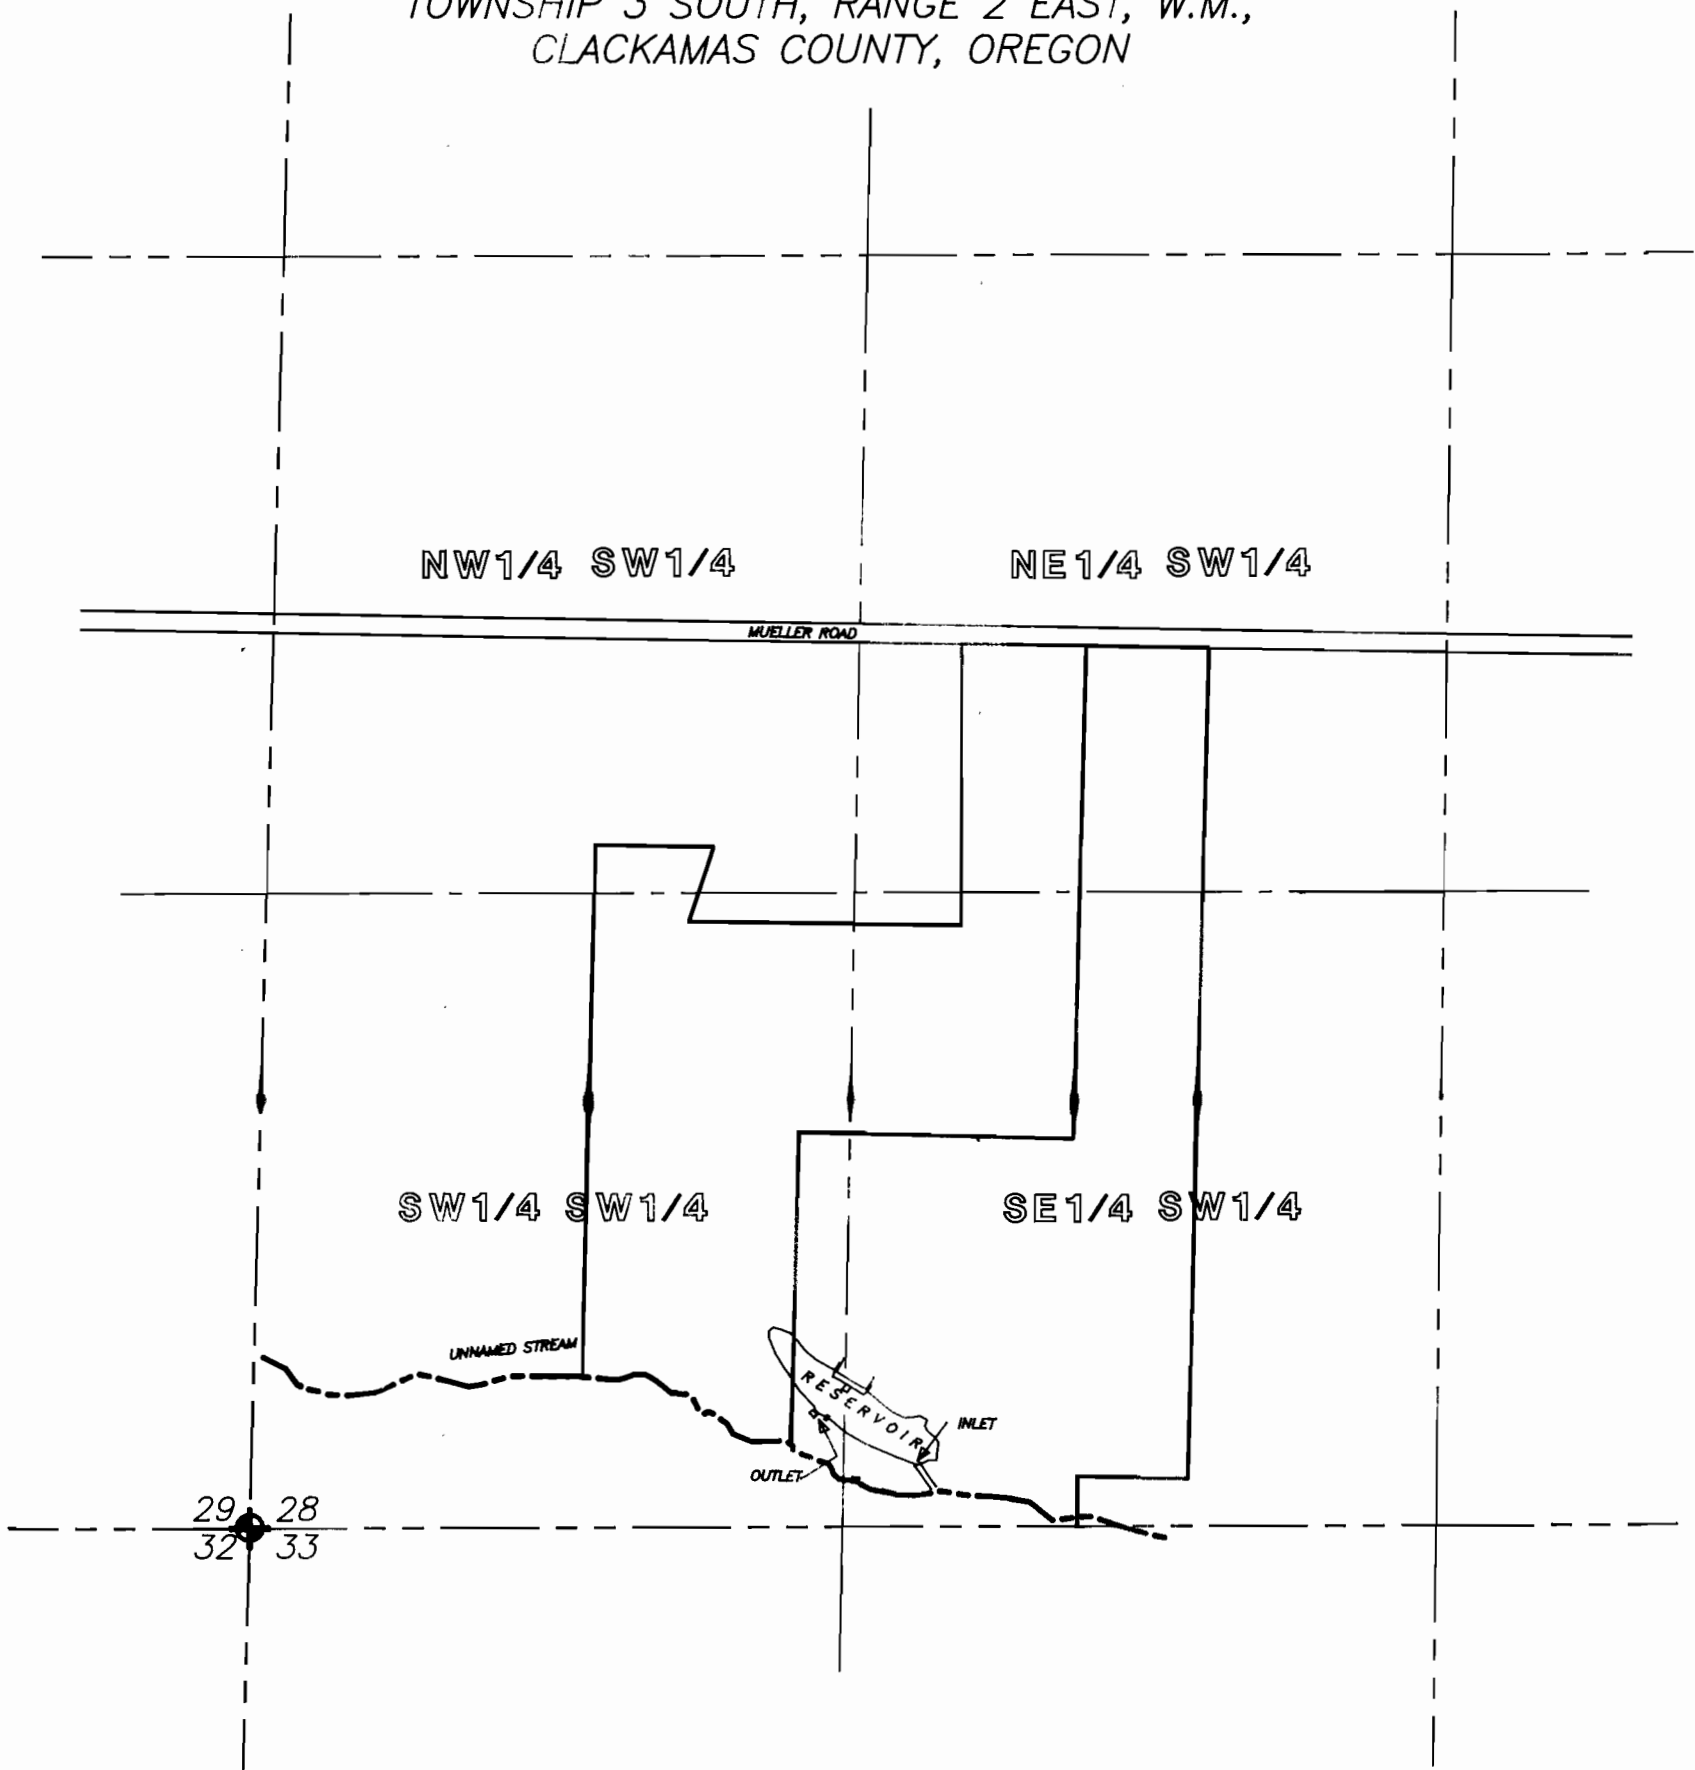

This drawing is an exhibit for a Reservoir Permit. This is not a land Survey. Property lines and/or other lines of occupation shown hereon are not represented by the undersigned to meet accuracy standards of Land Surveys.



200' 0 400' 800'
SCALE 1" = 400'

Application No. R-70382

Permit No. R-11235

H
R
S

HANER, ROSS &
SPORSEEN, INC.
15 S.E. 82ND DRIVE
GLADSTONE, OREGON 97027

FINAL PROOF SURVEY
RESERVOIR

MARCH 3, 1995

JOB #800