


T. 31 S., R. 9 W., W.M., Section 1

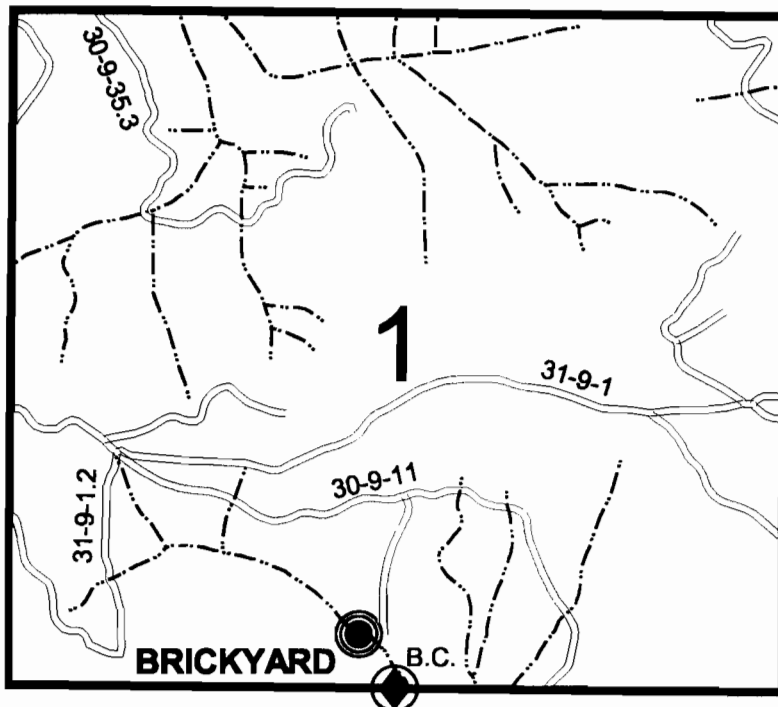

SCALE:
1" = 1320'



Diversion is:
374 ft. North and
243 ft. West of the
S 1/4 cor. Sec 1

CLAIM OF BENEFICIAL USE MAP

in name of

UNITED STATES BUREAU OF LAND MANAGEMENT

Application No.: R - 70709

S - 70514

Permit No.: R - 12009


52722

RECEIVED

SEP 25 2000

WATER RESOURCES DEPT.
SALEM, OREGON

SURVEYED: June 14, 2000

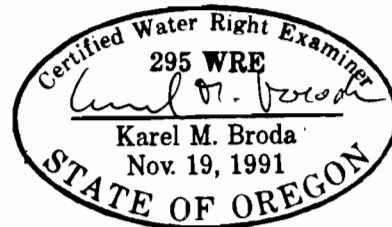


Expires: 12/31/01

THIS MAP WAS PREPARED FOR THE PURPOSE OF IDENTIFYING THE LOCATION OF A WATER RIGHT ONLY
AND IS NOT INTENDED TO PROVIDE LEGAL DIMENSIONS OR LOCATION OF PROPERTY OWNERSHIP LINES.

U.S. Bureau of Land Management
Roseburg District Office
Division of Operations

Executed by:
Karel M. Broda, PE, CWRE
777 N.W. Garden Valley Blvd.
Roseburg, Oregon 97470

FINAL PROOF MAP

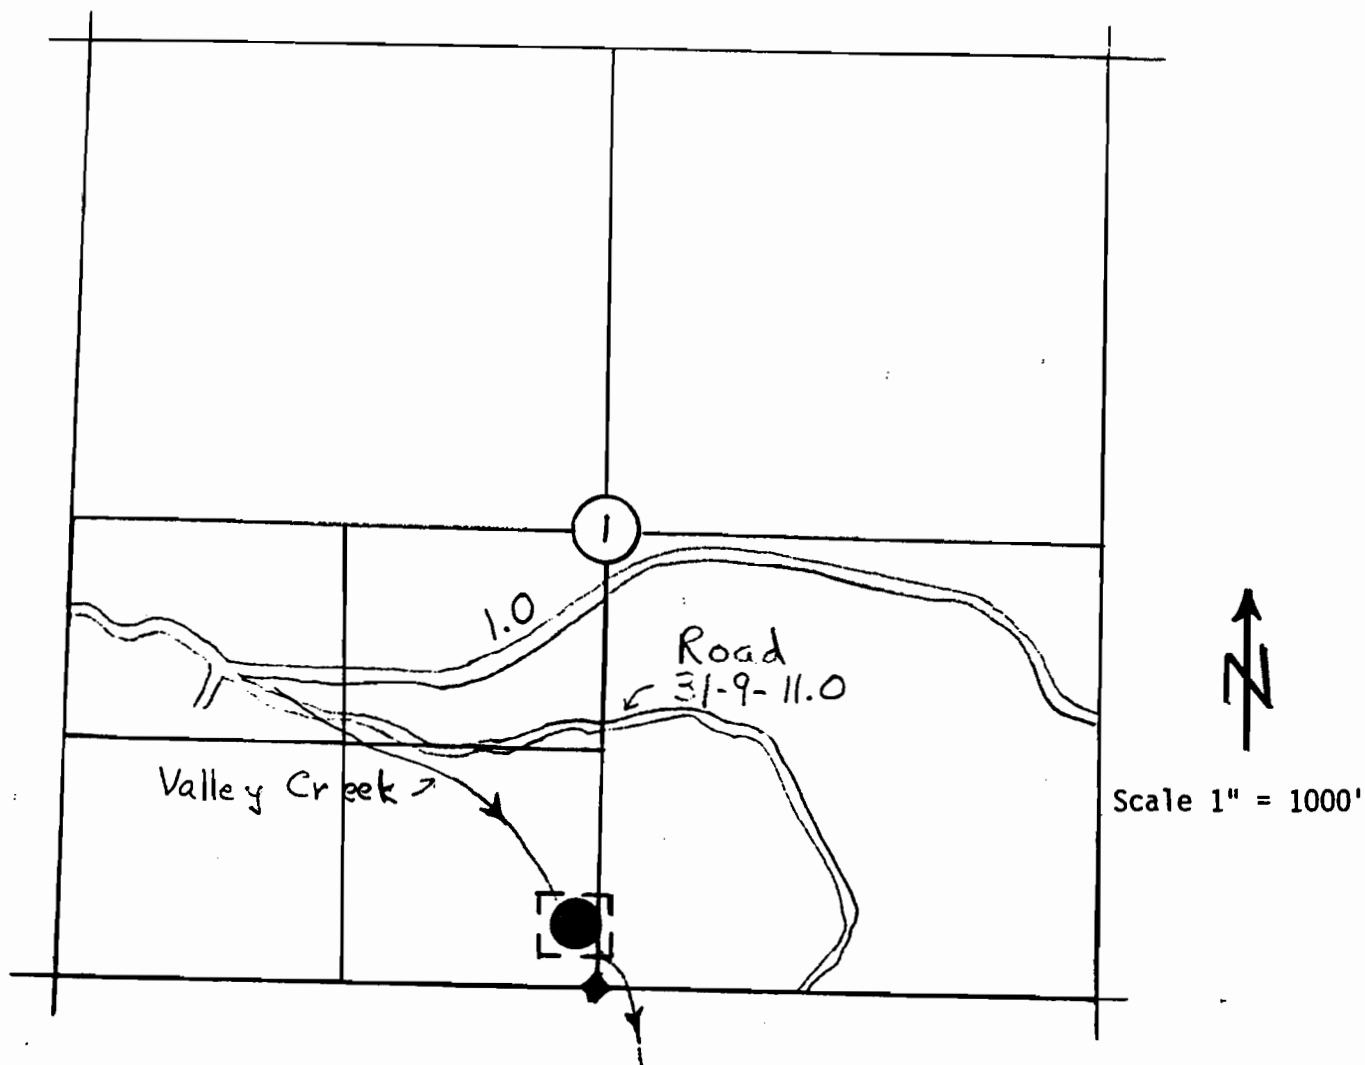

BRICKYARD RESERVOIR
T31S R9W Sec 1
SE $\frac{1}{4}$, SW $\frac{1}{4}$

The point of diversion is located 325 ft North and 150 ft West from the South Quarter Corner of Section 1.

Coordinate Ties are based on aerial photo 2-4-4-89

The map is shown for the purpose of water application and not property boundary.

APPLICATION: 70514, R. 70709
PERMIT: 70514

