


T. 31 S., R. 9 W., W.M., Section 1

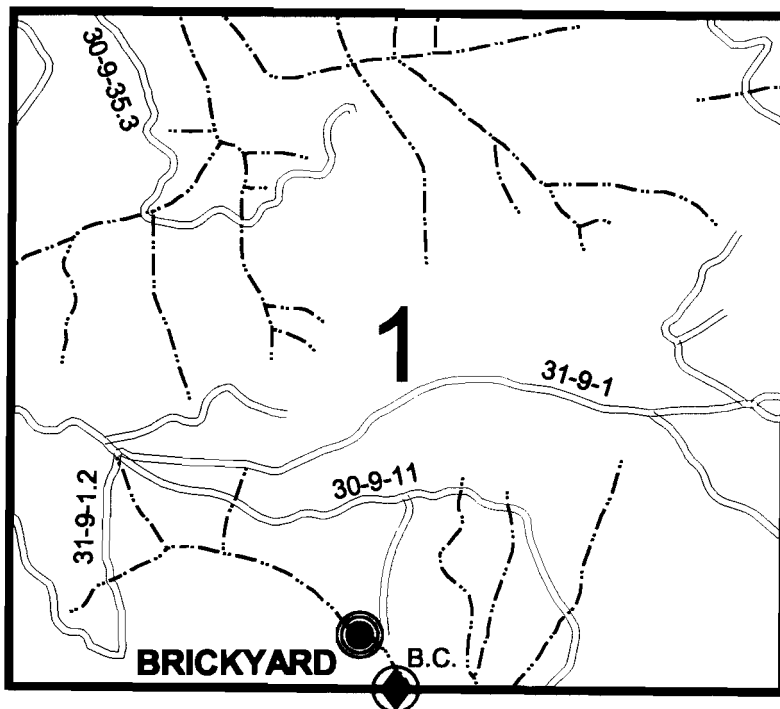

SCALE:
1" = 1320'



Diversion is:
374 ft. North and
243 ft. West of the
S 1/4 cor. Sec 1

CLAIM OF BENEFICIAL USE MAP

in name of

UNITED STATES BUREAU OF LAND MANAGEMENT

Application No.: R - 70709

S - 70514

Permit No.: R - 12009


52722

RECEIVED

SEP 25 2000

WATER RESOURCES DEPT.
SALEM, OREGON

SURVEYED: June 14, 2000

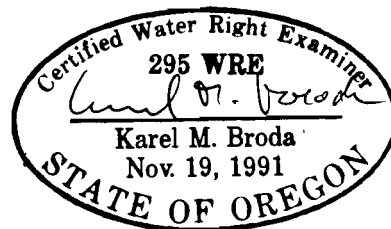


Expires: 12/31/01

THIS MAP WAS PREPARED FOR THE PUPOSE OF IDENTIFYING THE LOCATION OF A WATER RIGHT ONLY
AND IS NOT INTENDED TO PROVIDE LEGAL DIMENSIONS OR LOCATION OF PROPERTY OWNERSHIP LINES.

U.S. Bureau of Land Management
Roseburg District Office
Division of Operations

Executed by:
Karel M. Broda, PE, CWRE
777 N.W. Garden Valley Blvd.
Roseburg, Oregon 97470

FINAL PROOF MAP

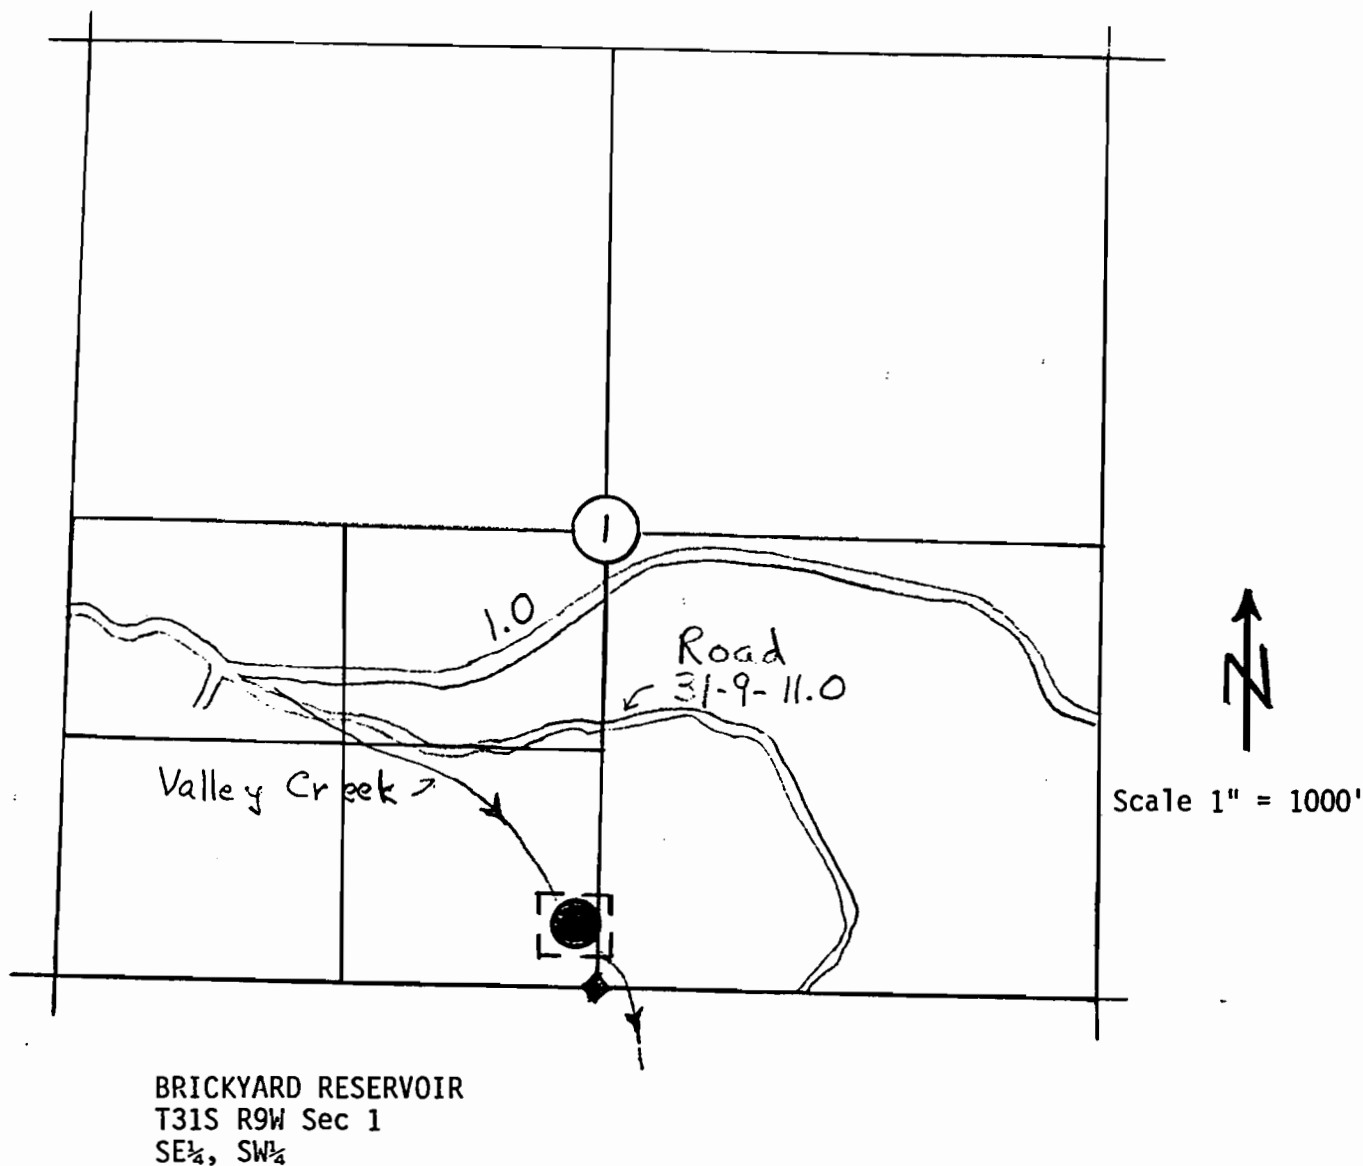


The point of diversion is located 325 ft North and 150 ft West from the South Quarter Corner of Section 1.

Coordinate Ties are based on aerial photo 2-4-4-89

The map is shown for the purpose of water application and not property boundary.

APPLICATION: 70514, R. 70709
PERMIT: 70514

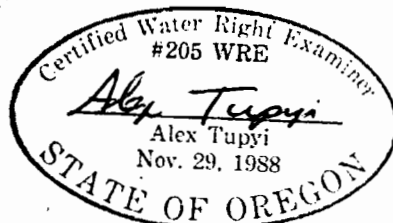

3-5-90