


T. 30 S., R. 6 W., W.M., Section 9

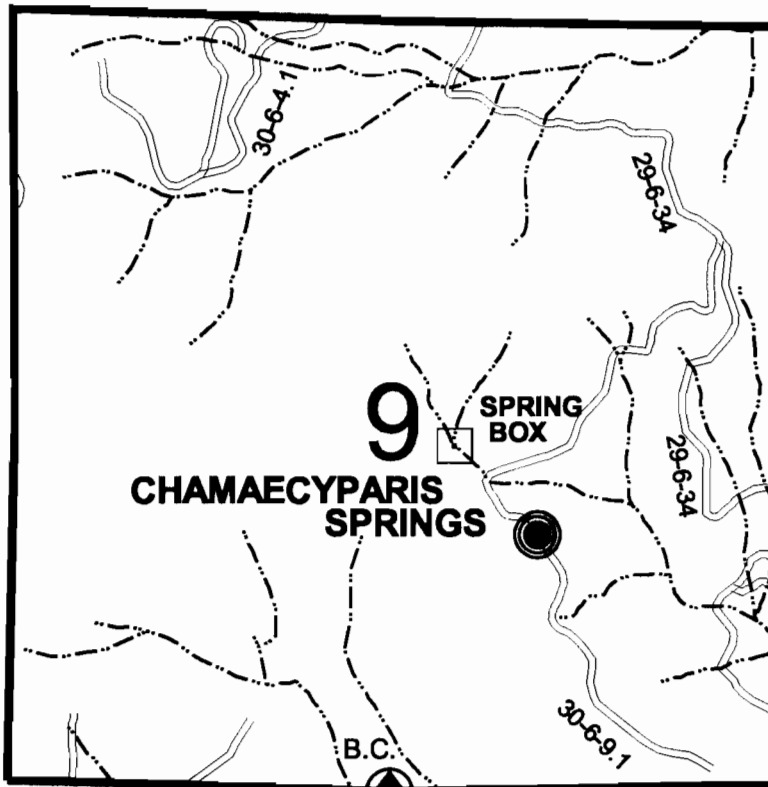

SCALE:
1" = 1320'



Spring Box Diversion is:
2362 ft. North and
440 ft. East of the
S 1/4 cor. Sec 9

Pond Diversion is:
1771 ft. North and
1014 ft. East of the
S 1/4 cor. Sec 9

CLAIM OF BENEFICIAL USE MAP

in name of

UNITED STATES BUREAU OF LAND MANAGEMENT

RECEIVED


SEP 25 2000

Application No.: R - 70710

S - 70517

Permit No.: R - 12117

53014

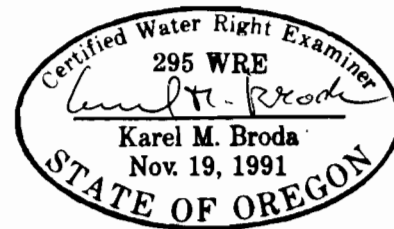

Expires: 12/31/01


SURVEYED: May 23, 2000

THIS MAP WAS PREPARED FOR THE PURPOSE OF IDENTIFYING THE LOCATION OF A WATER RIGHT ONLY
AND IS NOT INTENDED TO PROVIDE LEGAL DIMENSIONS OR LOCATION OF PROPERTY OWNERSHIP LINES.

U.S. Bureau of Land Management
Roseburg District Office
Division of Operations

Executed by:
Karel M. Broda, PE, CWRE
777 N.W. Garden Valley Blvd.
Roseburg, Oregon 97470

FINAL PROOF MAP

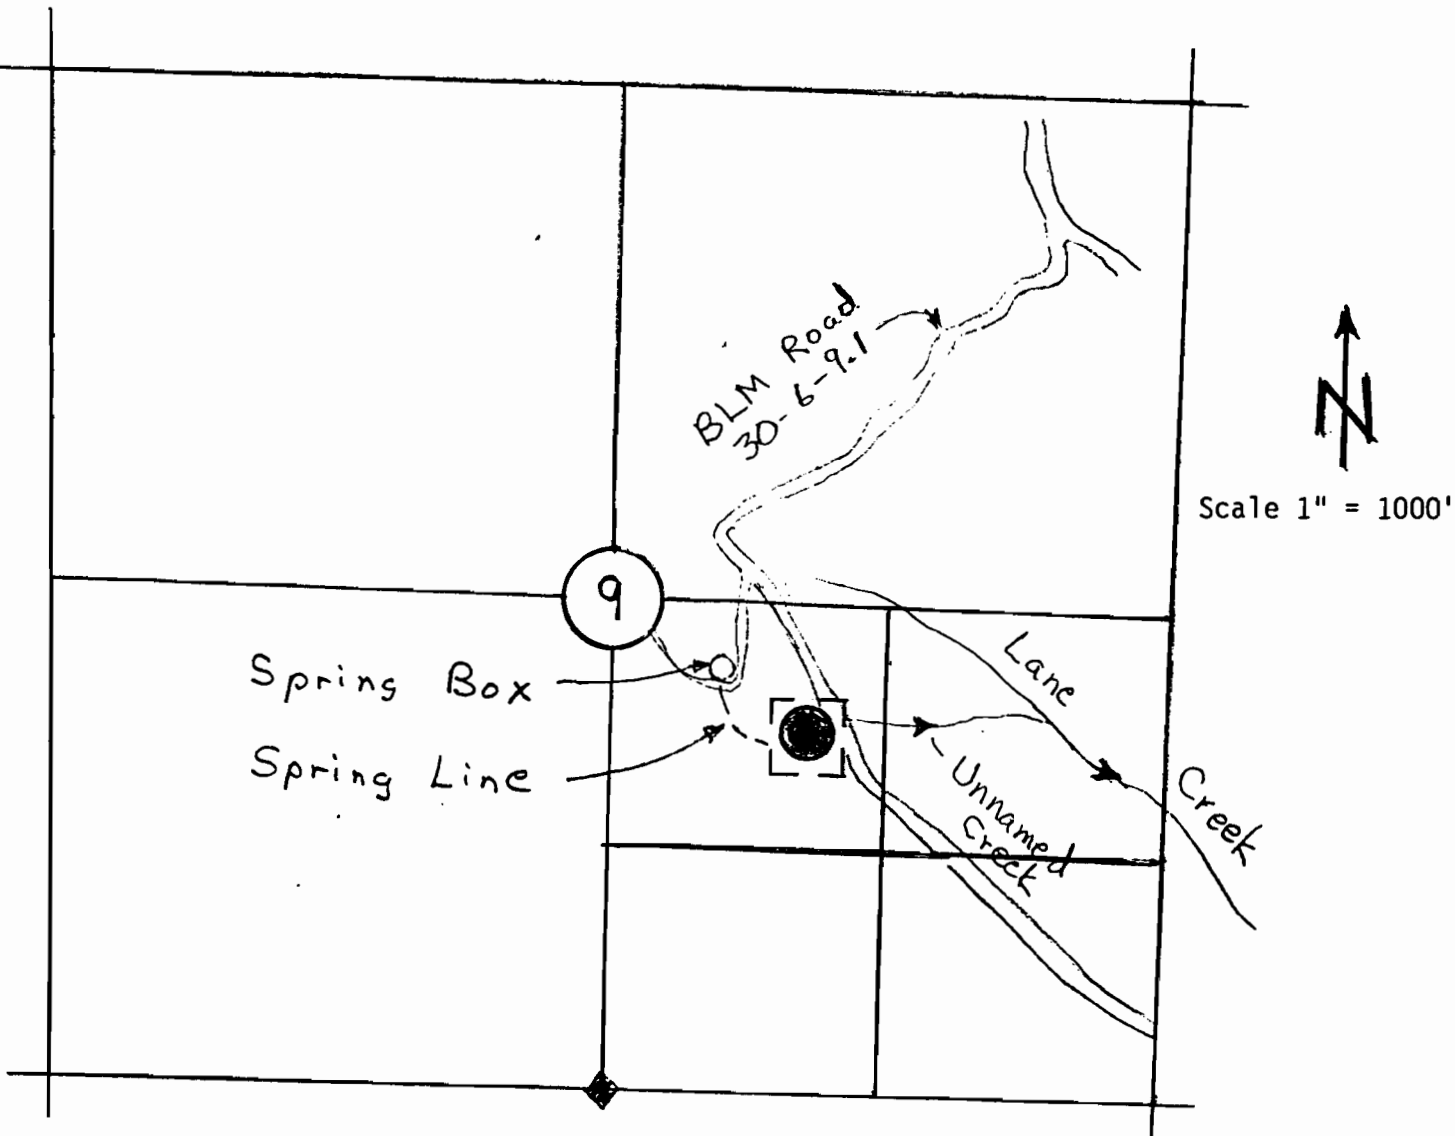


CHAMAECYPARIS SPRINGS PUMP CHANCE
T30S R6W Sec 9
NW $\frac{1}{4}$, SE $\frac{1}{4}$

The Spring Box is located 2300 ft North and 600 ft East from the South Quarter corner of Section 9. The Pump Chance is located 1950 ft North and 1000 ft East from the South Quarter corner of Section 9.

Coordinate Ties are based on aerial photo 16-19-18-89.

The map is shown for the purpose of water application and not property boundary.

APPLICATION: 70517, R. 70710
PERMIT: R-12117

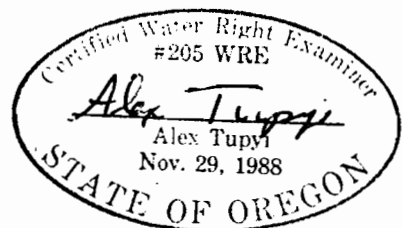

3-5-90