


T. 32 S., R. 6 W., W.M., Section 5

Spring Box Diversion is:
92 ft. South and
2394 ft. East of the
W 1/4 cor. Sec 5

Pond Diversion is:
745 ft. North and
2266 ft. East of the
W 1/4 cor. Sec 5

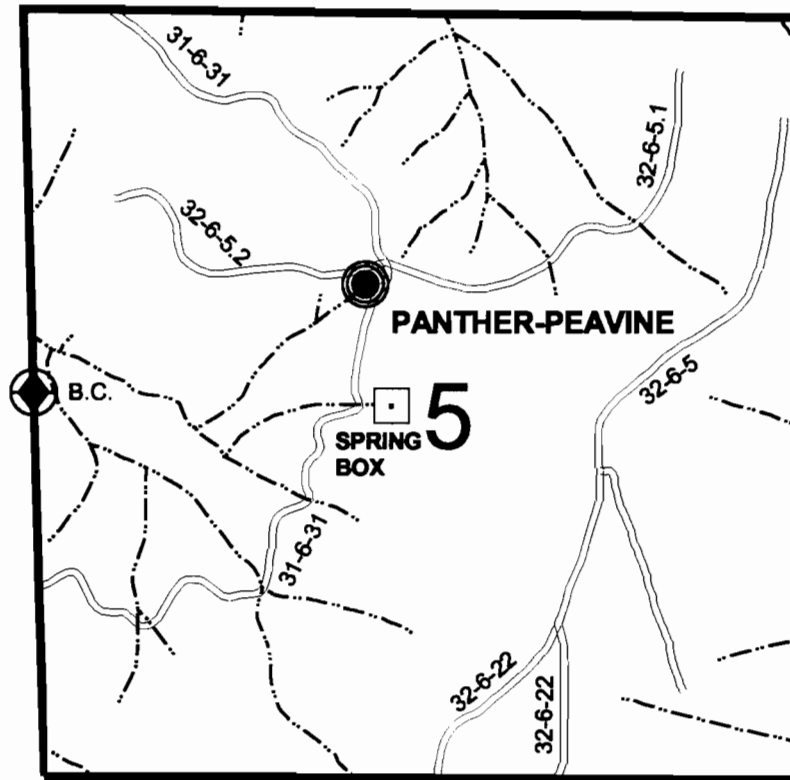

CLAIM OF BENEFICIAL USE MAP

in name of

UNITED STATES BUREAU OF LAND MANAGEMENT

Application No.: R - 70712

S - 70519

Permit No.: R - 11797

52282

RECEIVED

SEP 25 2000

WATER RESOURCES DEPT.
SALEM, OREGON



Expires: 12/31/01


SURVEYED: June 6, 2000

THIS MAP WAS PREPARED FOR THE PUPOSE OF IDENTIFYING THE LOCATION OF A WATER RIGHT ONLY
AND IS NOT INTENDED TO PROVIDE LEGAL DIMENSIONS OR LOCATION OF PROPERTY OWNERSHIP LINES.

U.S. Bureau of Land Management
Roseburg District Office
Division of Operations

Executed by:
Karel M. Broda, PE, CWRE
777 N.W. Garden Valley Blvd.
Roseburg, Oregon 97470

FINAL PROOF MAP

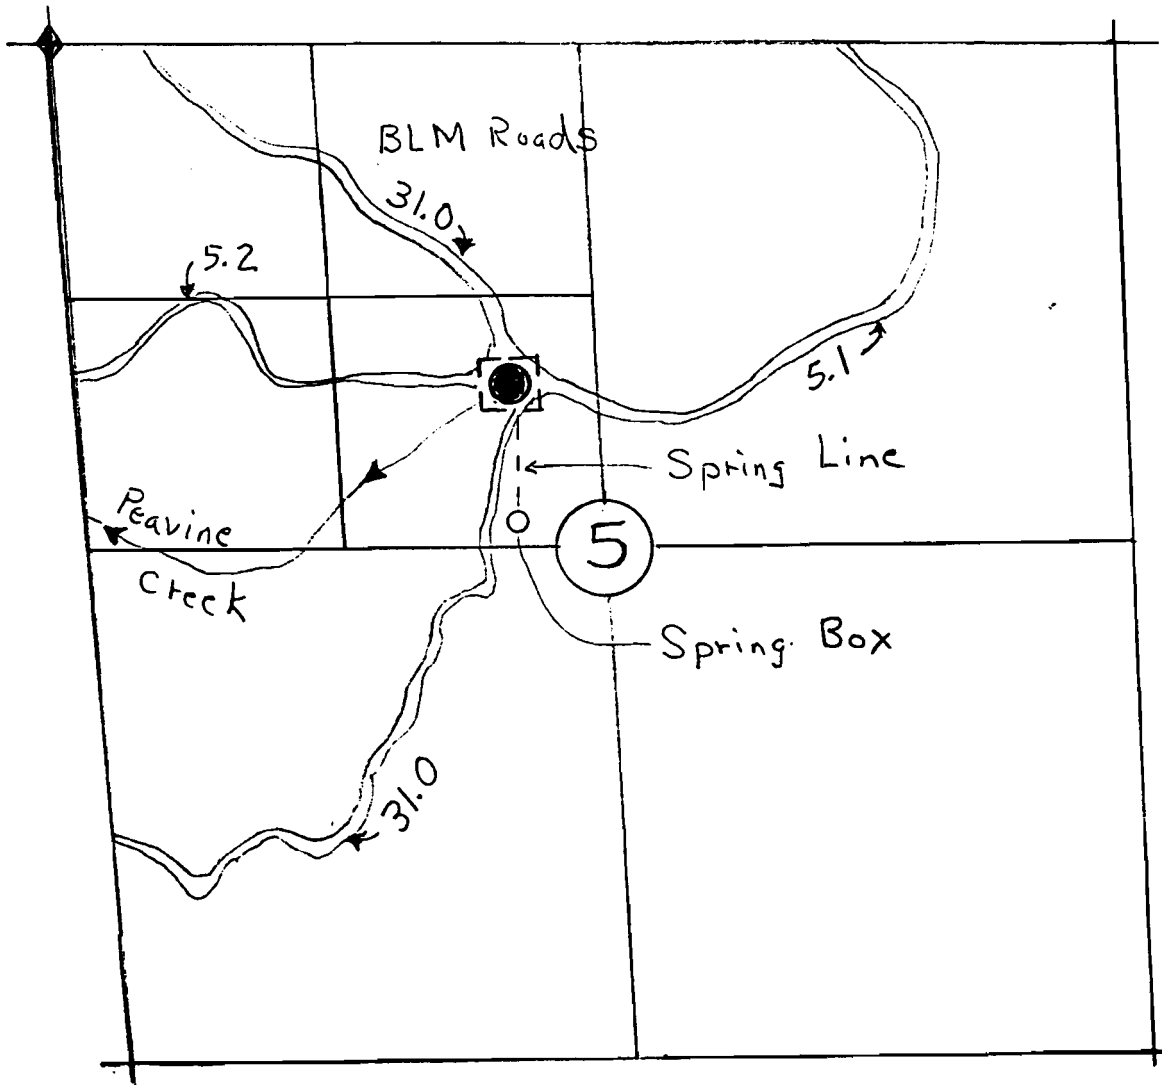

Scale 1" = 1000'


PANTHER-PEAVINE HELIPOND
T32S R6W Sec 5
SE $\frac{1}{4}$ NW $\frac{1}{4}$

The Spring Box is located at 2400 ft South and 2450 ft East from the Northwest Section Corner of Section 5. The Helipond is located 1850 ft South and 2350 ft East from the Northwest Section corner of Section 5.

Coordinate Ties are based on aerial photo 16-18-4-89.

The map is shown for the purpose of water application and not property boundary.

APPLICATION: 70519, R.70712
PERMIT:

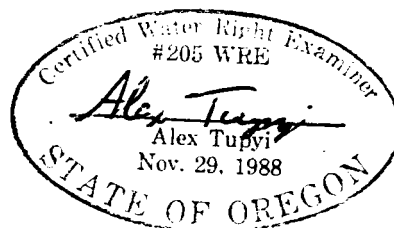

3-5-90