


T. 31 S., R. 8 W., W.M., Section 11

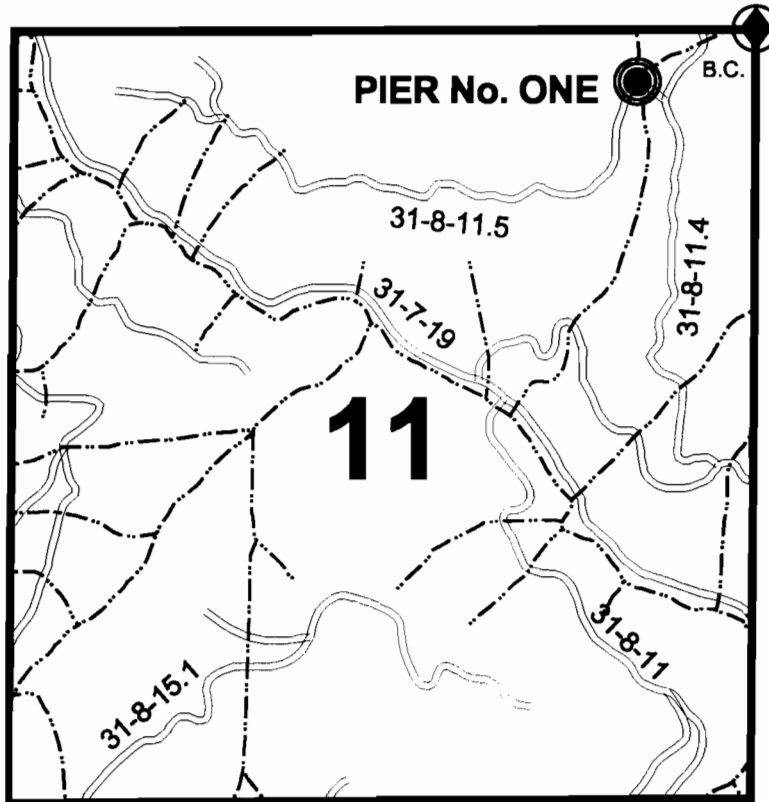

SCALE:
1" = 1320'



Diversion is:
351 ft. South and
804 ft. West of the
NE cor. Sec 11

CLAIM OF BENEFICIAL USE MAP

in name of

UNITED STATES BUREAU OF LAND MANAGEMENT

Application No.: R - 70713

S - 70521

Permit No.: R - 12032

52777

RECEIVED

SEP 25 2000



Expires: 12/31/01


SURVEYED: May 2, 2000

THIS MAP WAS PREPARED FOR THE PUPOSE OF IDENTIFYING THE LOCATION OF A WATER RIGHT ONLY
AND IS NOT INTENDED TO PROVIDE LEGAL DIMENSIONS OR LOCATION OF PROPERTY OWNERSHIP LINES.

U.S. Bureau of Land Management
Roseburg District Office
Division of Operations

Executed by:
Karel M. Broda, PE, CWRE
777 N.W. Garden Valley Blvd.
Roseburg, Oregon 97470

FINAL PROOF MAP

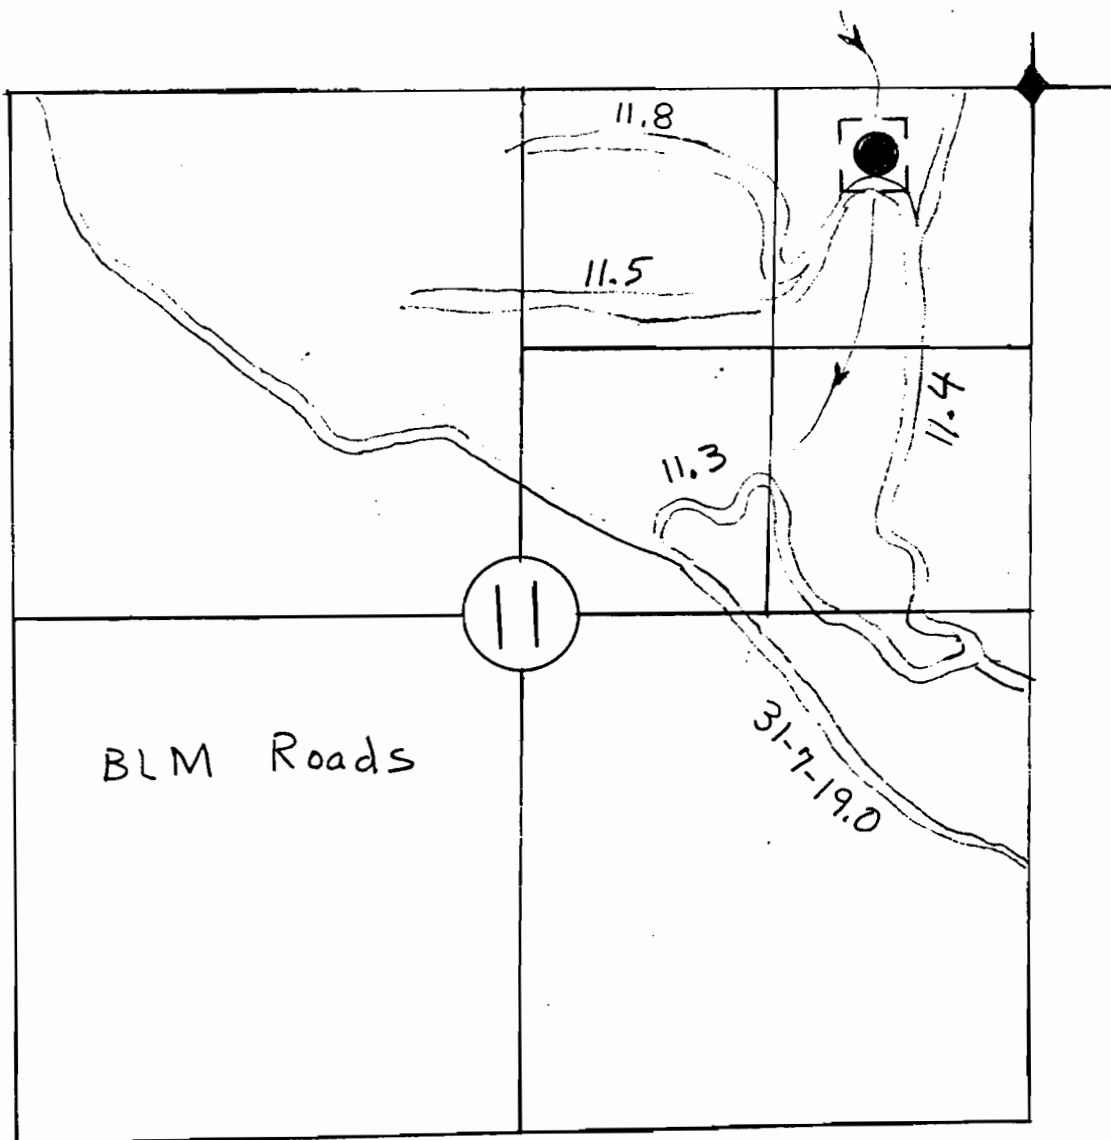

Scale 1" = 1000'


PIER NO. 1 PUMP CHANCE
T31S R8W Sec 11
NE $\frac{1}{4}$ NE $\frac{1}{4}$

The point of diversion is located 450 ft South and 850 ft West from the Northeast Section corner of Section 11.

Coordinate Ties are based on aerial photo 4-9-14-89.

The map is shown for the purpose of water application and not property boundary.

APPLICATION: 70521, R. 70713
PERMIT: 1115-88

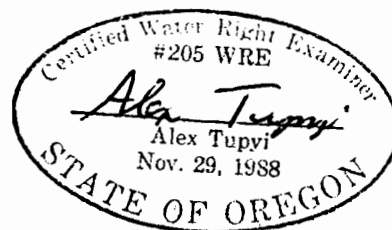

3-5-90