


# T. 31 S., R. 8 W., W.M., Section 11

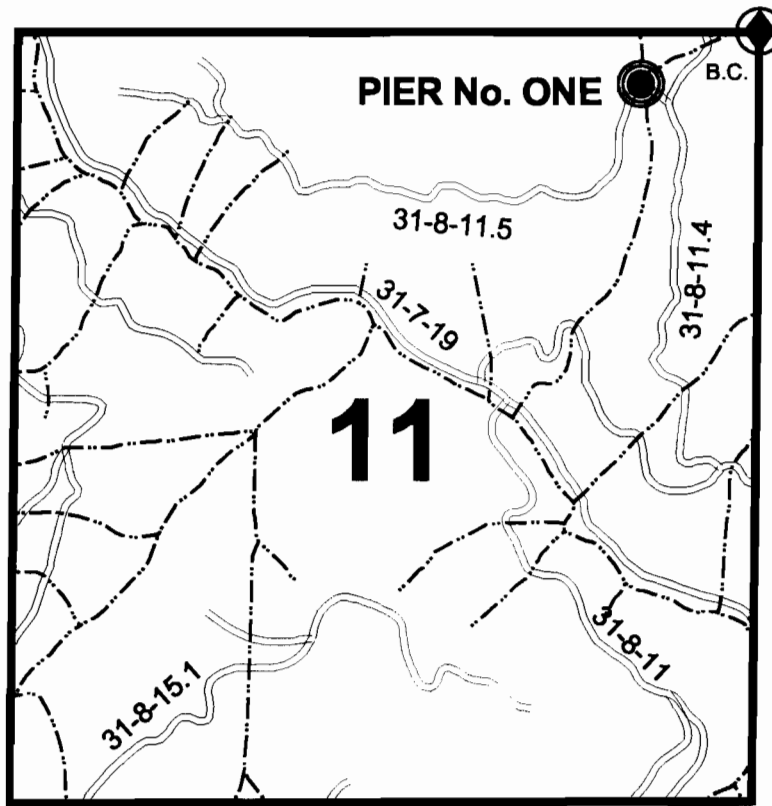

SCALE:  
1" = 1320'



**Diversion is:**  
**351 ft. South and**  
**804 ft. West of the**  
**NE cor. Sec 11**

## CLAIM OF BENEFICIAL USE MAP

in name of

**UNITED STATES BUREAU OF LAND MANAGEMENT**

**Application No.: R - 70713**


**S - 70521**

**Permit No.: R - 12032**

**52777**

**RECEIVED**

SEP 25 2000

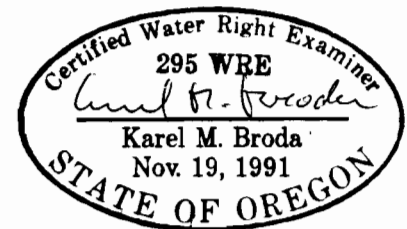

Expires: 12/31/01


**SURVEYED: May 2, 2000**

THIS MAP WAS PREPARED FOR THE PUPOSE OF IDENTIFYING THE LOCATION OF A WATER RIGHT ONLY  
AND IS NOT INTENDED TO PROVIDE LEGAL DIMENSIONS OR LOCATION OF PROPERTY OWNERSHIP LINES.

U.S. Bureau of Land Management  
Roseburg District Office  
Division of Operations

Executed by:  
Karel M. Broda, PE, CWRE  
777 N.W. Garden Valley Blvd.  
Roseburg, Oregon 97470

FINAL PROOF MAP

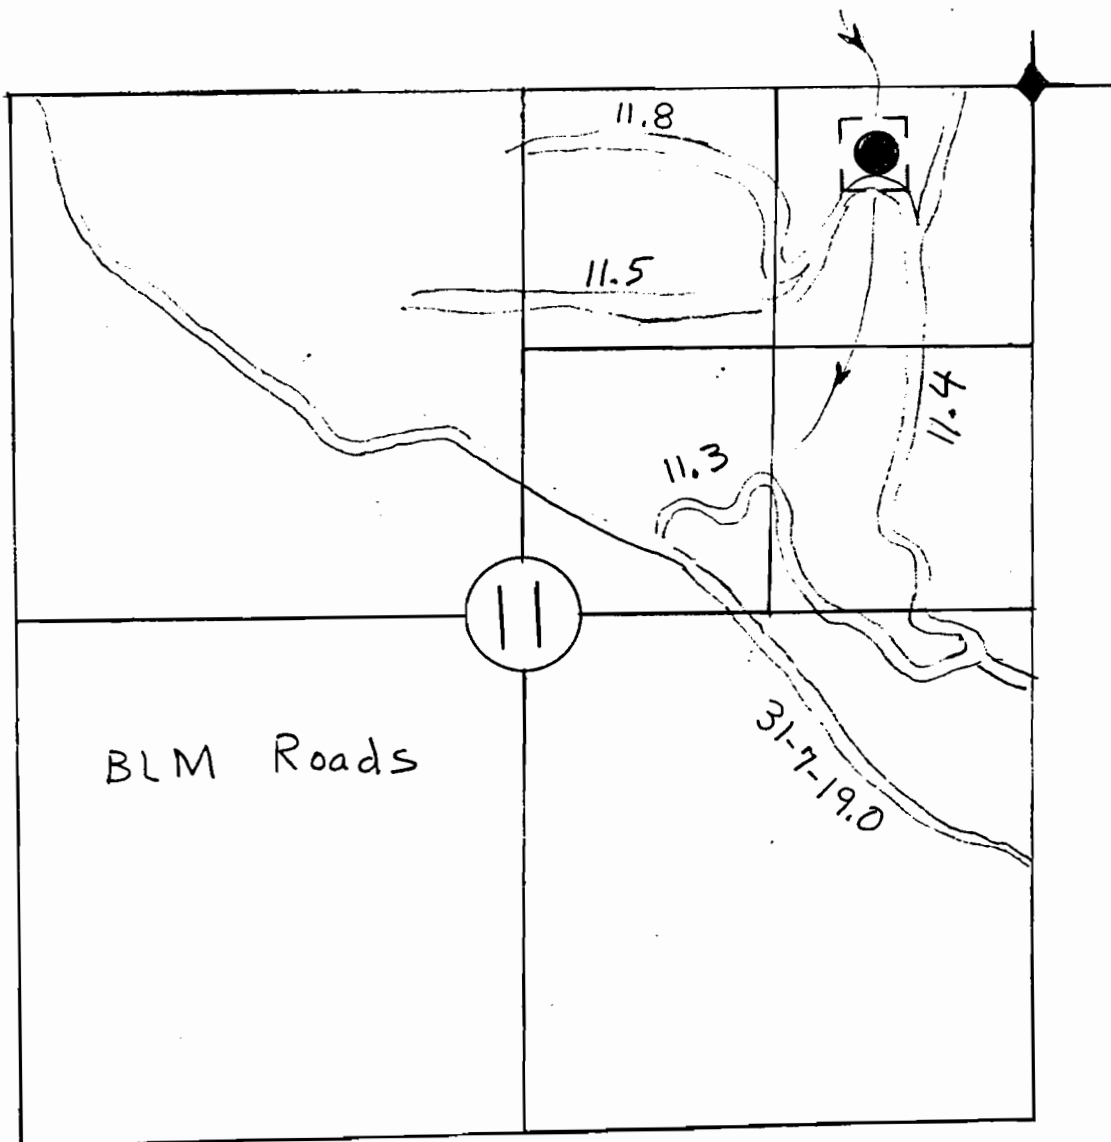

Scale 1" = 1000'


PIER NO. 1 PUMP CHANCE  
T31S R8W Sec 11  
NE  $\frac{1}{4}$  NE  $\frac{1}{4}$

The point of diversion is located 450 ft South and 850 ft West from the Northeast Section corner of Section 11.

Coordinate Ties are based on aerial photo 4-9-14-89.

The map is shown for the purpose of water application and not property boundary.

APPLICATION: 70521, R. 70713  
PERMIT: 115-88

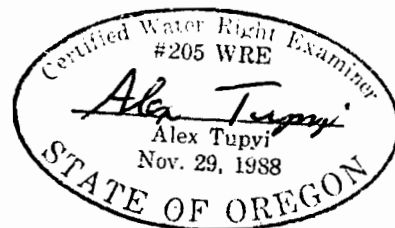

3-5-90