


BEARINGS BASED ON M 96-66

NORTH LINE CARSON DLC 42

SECTION SUBDIVISION
PER M 60-35

T29S R4W WM

1.5" PIPE

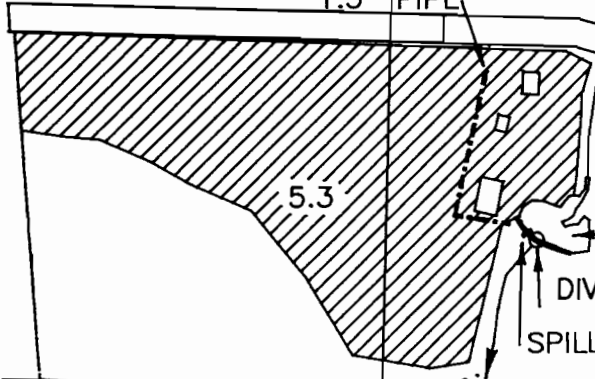

COUNTY RD # 18

CARSON DLC 42 E. LINE

SW 1/4 SE 1/4

SW 1/4
SW 1/4

SE 1/4
SW 1/4

UNNAMED STR.

SECTION 19

SECTION 30

DIV PT IS 670' N. & 950' W.
FROM 1/4 COR. SEC. 19 & SEC. 30

NW 1/4
NW 1/4

BC 1/4 COR.
S19/S30


NW 1/4 NE 1/4

NE 1/4
NW 1/4

this map
for water right
purposes only

PROPERTY LINE

SOUTH MYRTLE CREEK

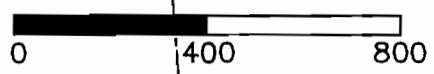

SCALE



SOUTH LINE CARSON DLC 42

SUPPLEMENTAL TO PERMIT 48286

Final Proof Survey

IN NAME OF *Roy & Mary Anderson*

APPLICATION S-70928 PERMIT R-11781

APPLICATION S-70929 PERMIT 52148

DATE SEPTEMBER 14, 1997

RECEIVED

BY: WILLIAM J. RUPPERT
P.O. BOX 1564
MYRTLE CREEK, OR 97457

SEP 17 1997

WATER RESOURCES DEPT.
SALEM OREGON

