


FINAL PROOF SURVEY MAP
IN THE NAME OF JACKSON RANCH, INCORPORATED
SECTION 35, TOWNSHIP 25 SOUTH, RANGE 5 WEST, W.M.
APPLICATION R-74308 PERMIT R-12025

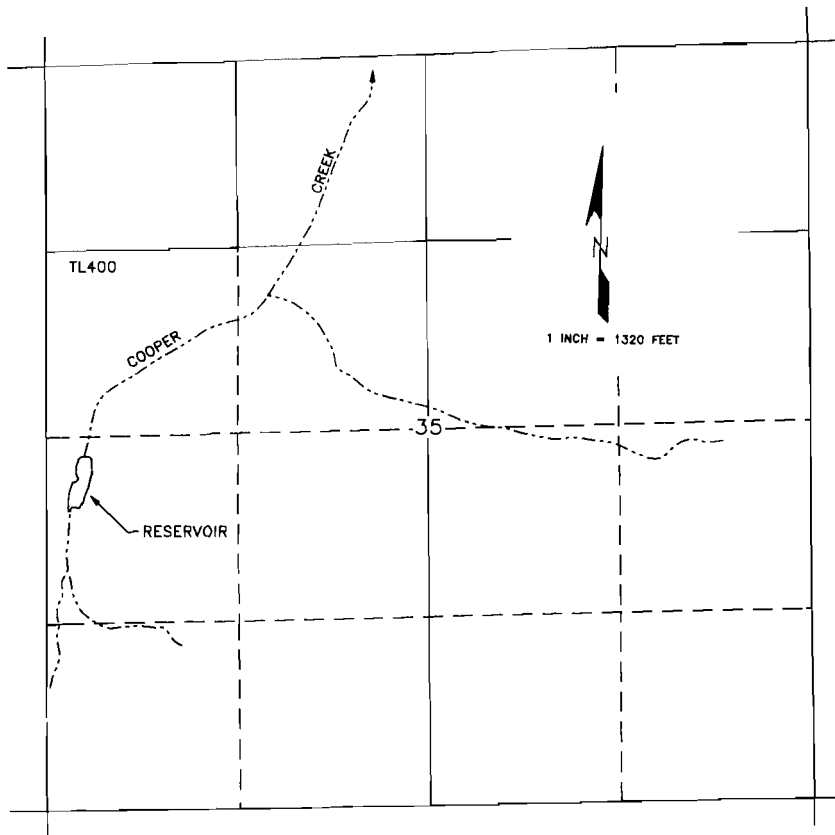

THE PURPOSE OF THIS MAP IS TO IDENTIFY THE LOCATION OF THE WATER RIGHT. IT IS NOT INTENDED TO PROVIDE INFORMATION RELATIVE TO THE LOCATION OF PROPERTY OWNERSHIP BOUNDARY LINES.

