


T. 8S., R. 44E., W.M.

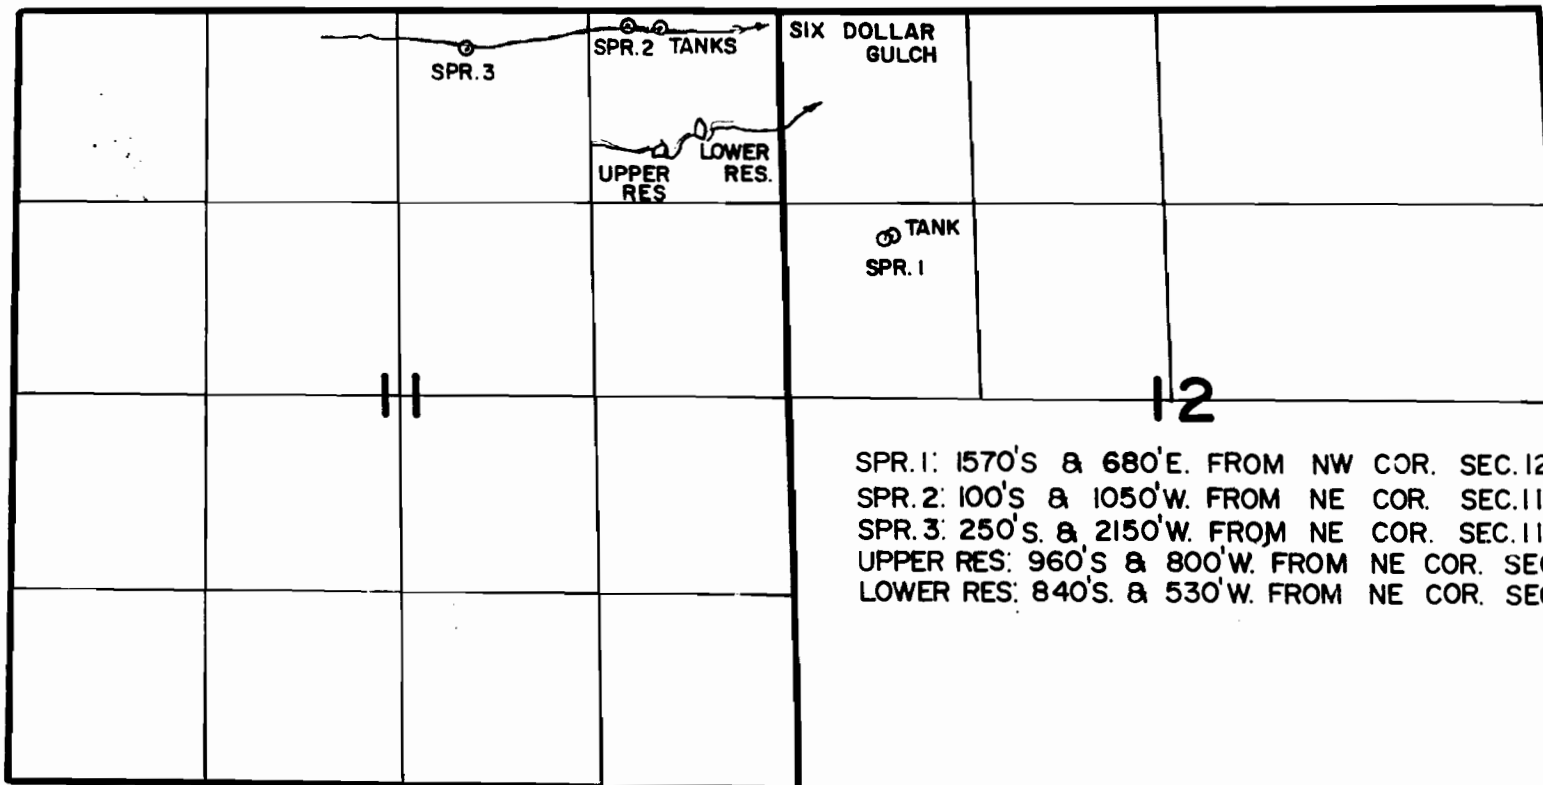

SPR. 1: 1570'S & 680'E. FROM NW COR. SEC. 12
 SPR. 2: 100'S & 1050'W. FROM NE COR. SEC. 11
 SPR. 3: 250'S & 2150'W. FROM NE COR. SEC. 11
 UPPER RES: 960'S & 800'W. FROM NE COR. SEC. 11
 LOWER RES: 840'S & 530'W. FROM NE COR. SEC. 11

THE PURPOSE OF THIS MAP IS FOR IDENTIFYING THE LOCATION OF THE WATER RIGHT ONLY AND IS NOT INTENDED TO PROVIDE LEGAL DIMENSIONS OF PROPERTY OWNERSHIP LINES

FINAL PROOF SURVEY


APPL. R-71056
 71057

PER. R-11828
 52465

IN NAME OF

Jeffery R. Young, John R. Mitchell &
 Zandra R. Curry

Surveyed June 14, 1998

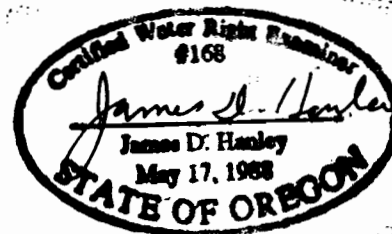

RECEIVED

AUG 12 1998

WATER RESOURCES DEPT.
 SALEM, OREGON