

RECEIVED

FINAL PROOF MAP

JAN 2 1998

UNDER APPLICATION No. R-71111, PERMIT No. R-11867 WATER RESOURCES DEPT
SALEM, OREGON





Applicant:

Walter S. Saunders, Jr.
Route 1 Box 21
Richland, OR 97870

Scale 1" = 1320'

To Sparte

T9S R45E

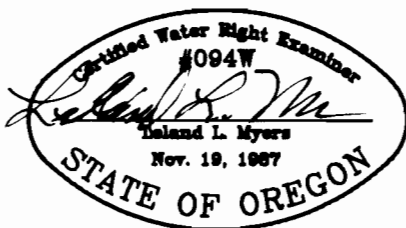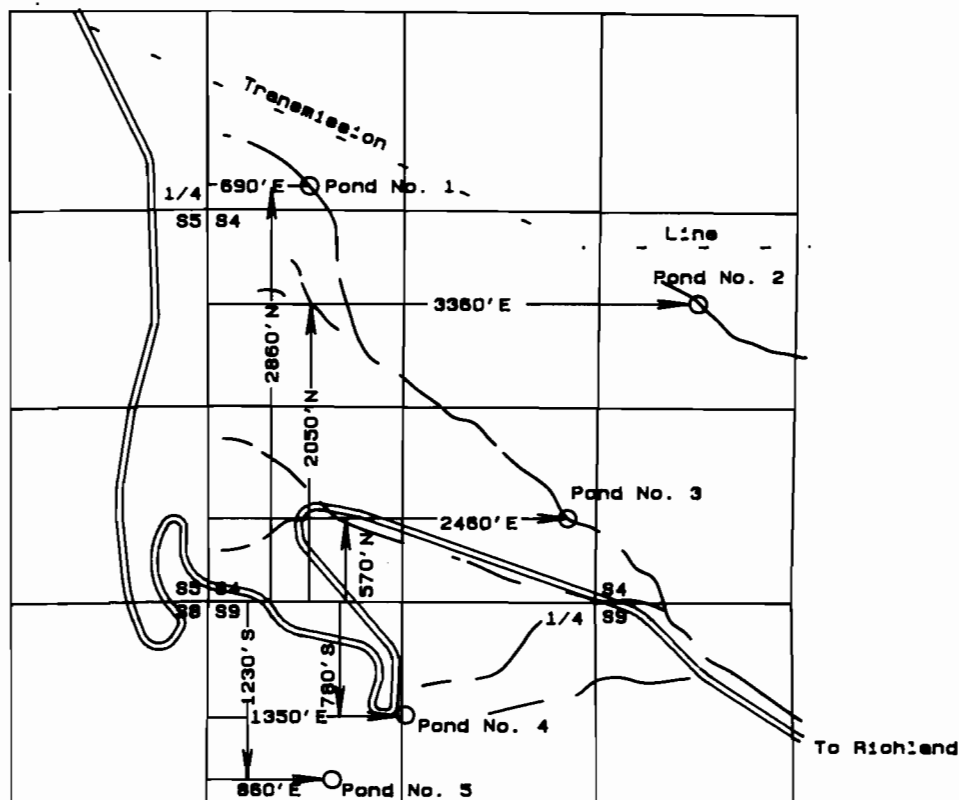

This map is for the purpose of identifying the location of the water right only and has no intent to provide dimensions or location of property ownership lines.