


RECEIVED

ASOTIN CO., WASHINGTON
WALLOWA CO., OREGON

MAR 21 1995

WATER RESOURCES DEPT
SALEM, OREGON

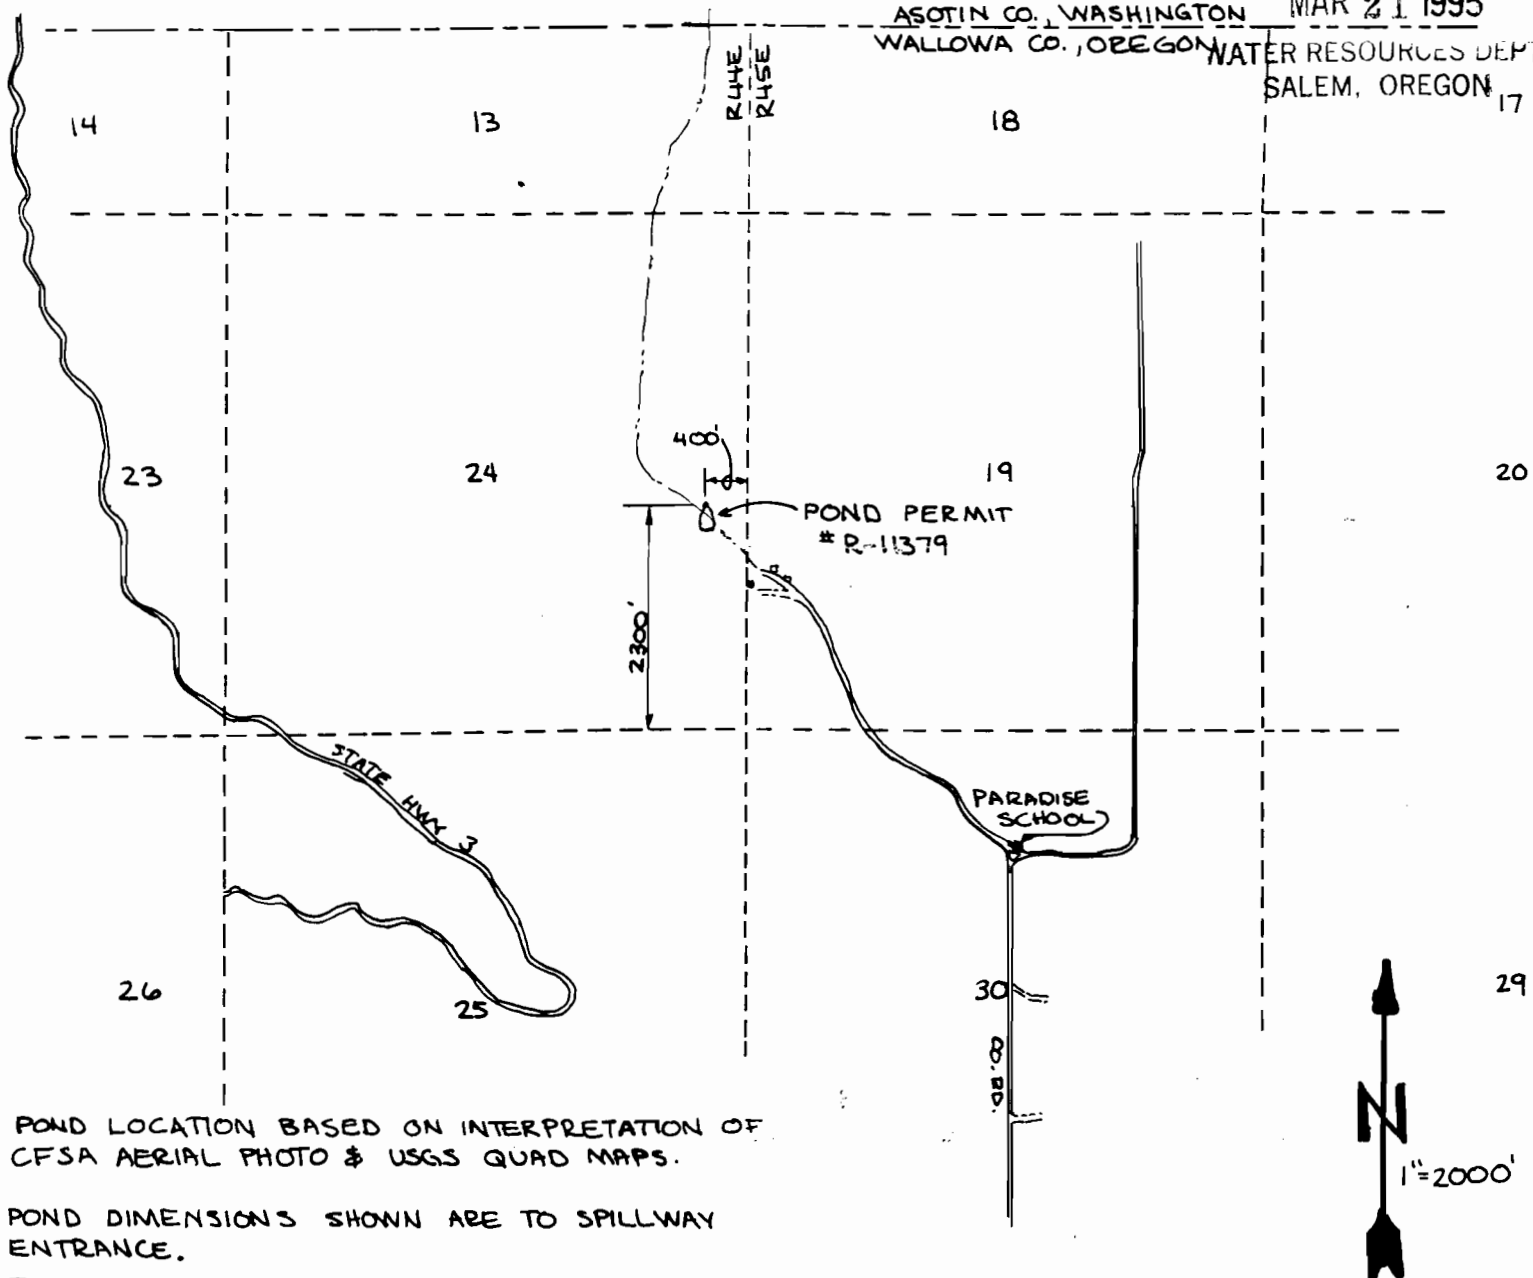

POND LOCATION BASED ON INTERPRETATION OF
CFSA AERIAL PHOTO & USGS QUAD MAPS.

POND DIMENSIONS SHOWN ARE TO SPILLWAY
ENTRANCE.

POND HAS SURFACE AREA OF 0.6 ACRE
AND STORES 4.0 ACRE-FT.

SEE ATTACHED SITE REPORT

IN SECTION 24
T6N, R44E, W.M.

NOTE:

THIS MAP IS PREPARED FOR WATER RIGHT
PURPOSES ONLY AND SHOULD NOT BE
USED FOR PROPERTY LINE LOCATION.



IN SECTION 24, T6N, R44E, WM
WALLOWA COUNTY

FINAL PROOF MAP
POND PERMIT #R-11379
TEJAN, INC