


DIV PT 350 EAST AND 150 SOUTH FROM THE
N.E. CORNER OF PLC 62 AS PROJECTED IN
SEC. 29, T5S, R6W WM

AREA OF USE S. 1/2 OF N.E. AND N. 1/2 OF S.E.
OF SEC. 29 T5S, R6W W.M.

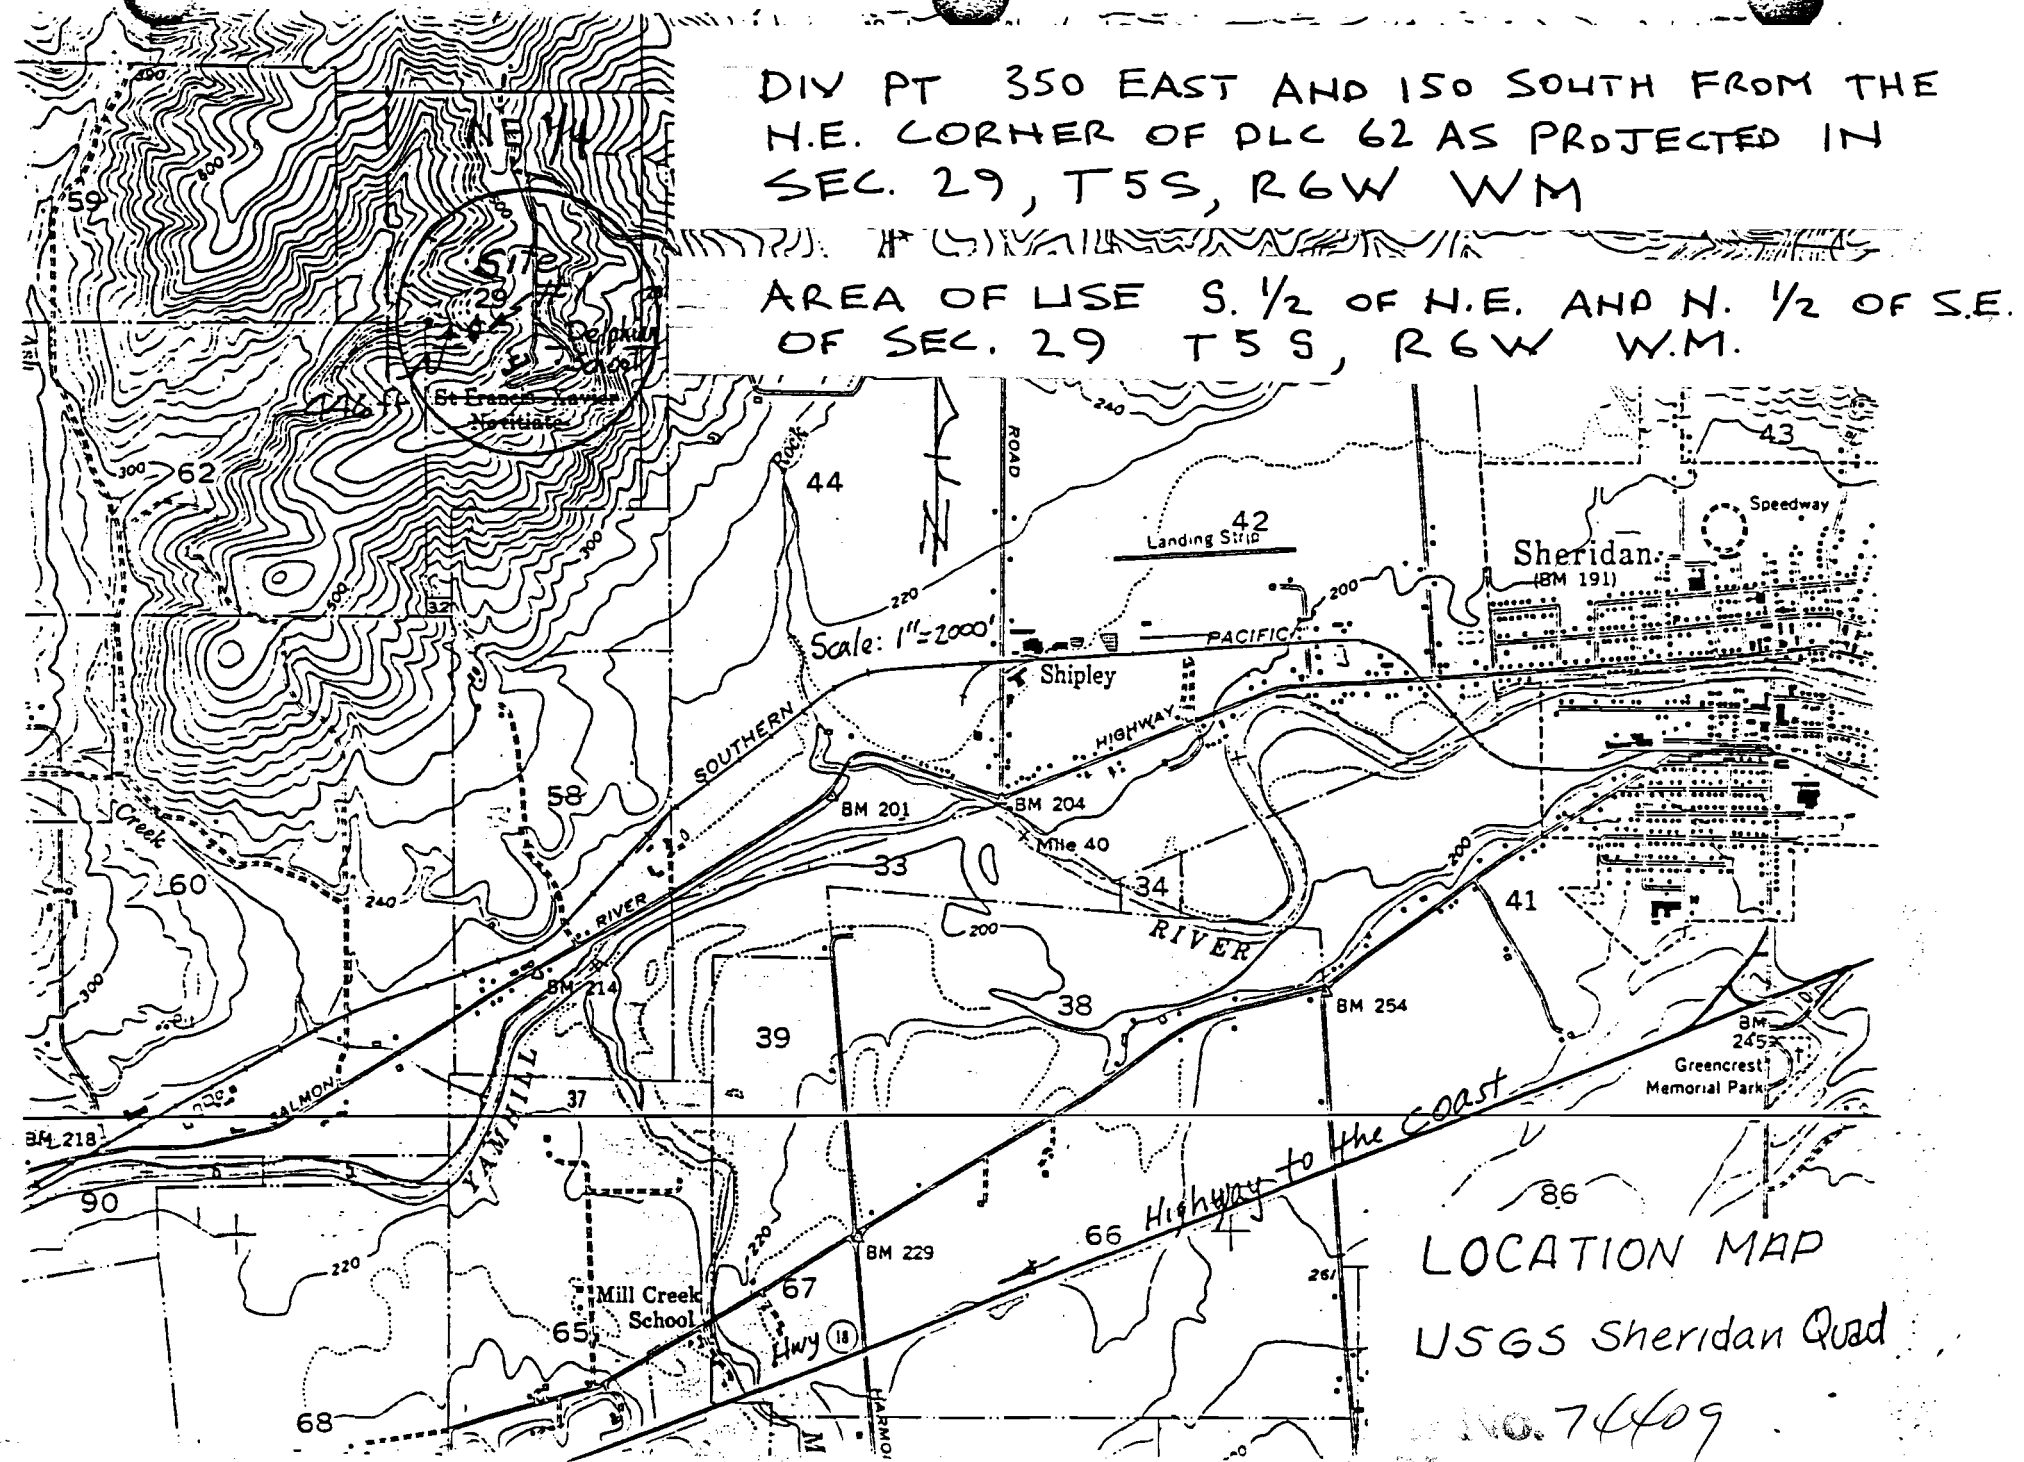

LOCATION MAP
USGS Sheridan Quad
No. 74409

Permit No.