



THIS MAP WAS PREPARED FOR THE PURPOSE OF IDENTIFYING THE LOCATION OF THE WATER RIGHT AND IS NOT INTENDED TO PROVIDE LEGAL DIMENSIONS OR LOCATIONS OF PROPERTY OWNERSHIP LINES.

T3N, R1W

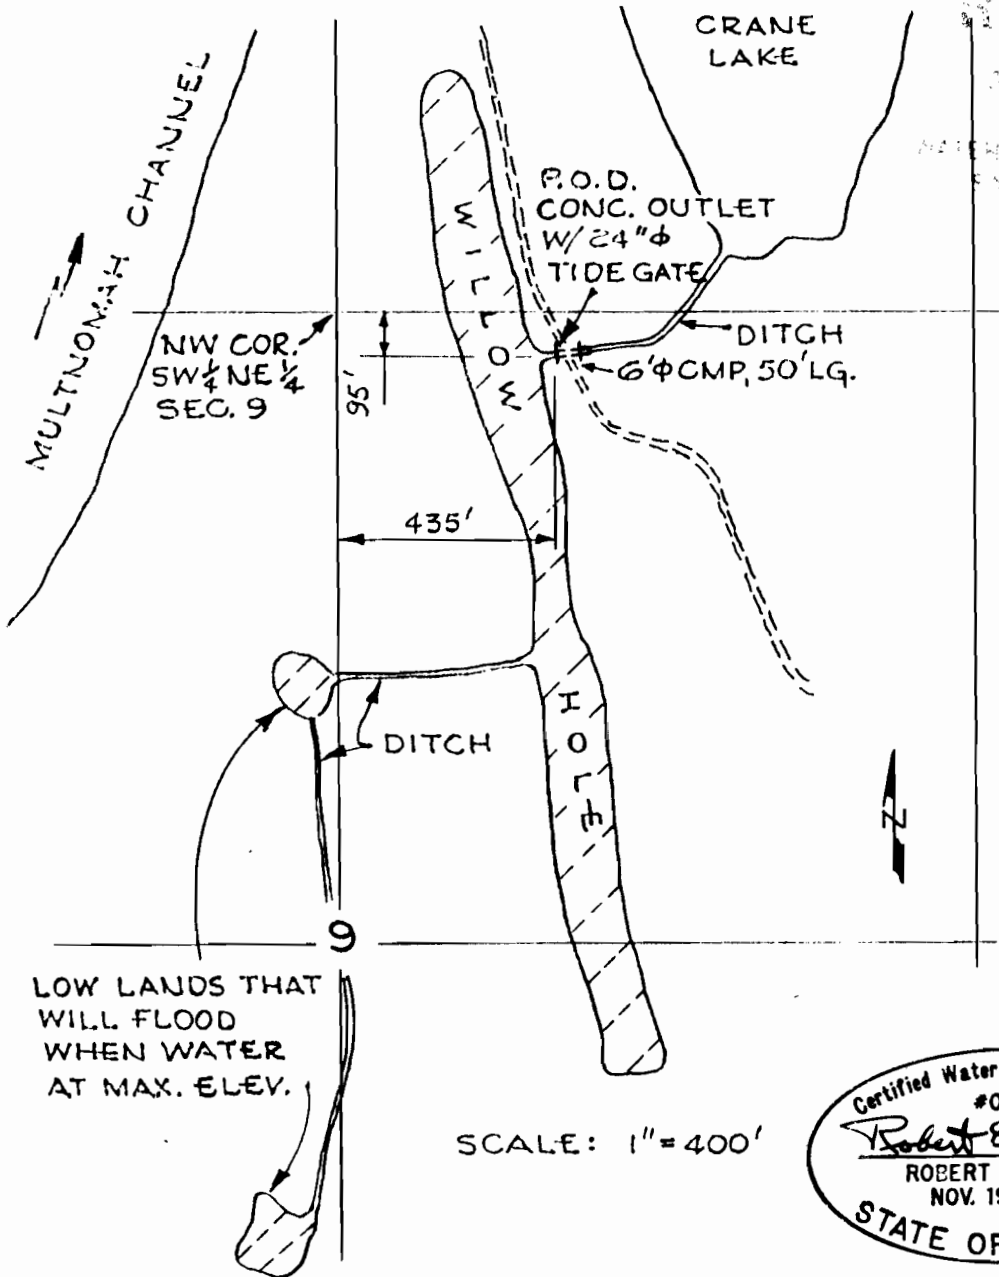

LOW LANDS THAT WILL FLOOD WHEN WATER AT MAX. ELEV.

SCALE: 1" = 400'

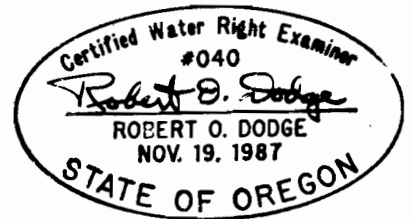

FINAL PROOF SURVEY UNDER

APPLICATION NO. R-71306 PERMIT NO. R-11551

IN NAME OF

OREGON DEPARTMENT OF FISH AND WILDLIFE

SURVEYED: 3/4/96

BY: DODGE