


T.4 S., R.9 W., W.M.

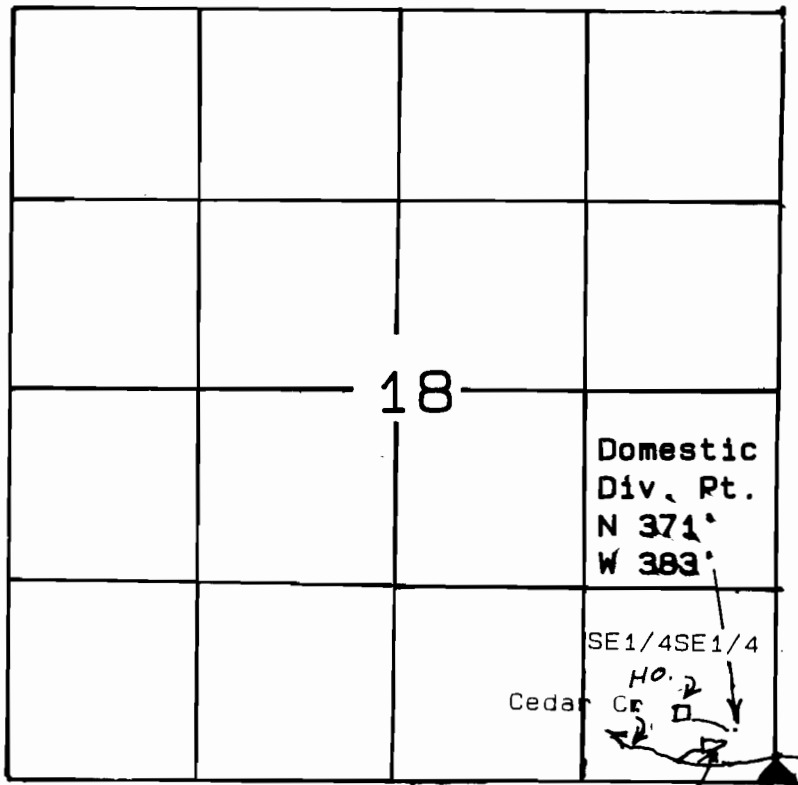

SCALE
1"=1320'

SE cor. Sec 18
3" USFS CAP
N 0.0'. W 0.0'

Reservoir
N 323' & W 515'

in the name of
BARBARA NACHMANN

FINAL PROOF SURVEY

Application No. S-71331 R-73330

Permit No. S-51241 R-11385

February 6, 1992

