

**RECEIVED**



**AUG 08 2000**

**WATER RESOURCES DEPT.  
SALEM, OREGON**

**FINAL PROOF SURVEY MAP  
IN THE NAME OF  
WALTER R. DICKOVER  
JERRY W. REDENIUS  
COMMON VENTURES, INC.**

**APPLICATION R-74486    PERMIT R-12092  
APPLICATION S-74487    PERMIT 52974**

**SECTION 32, TOWNSHIP 28 SOUTH, RANGE 7 WEST, W.M.**

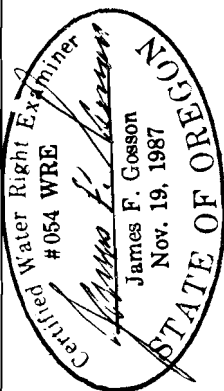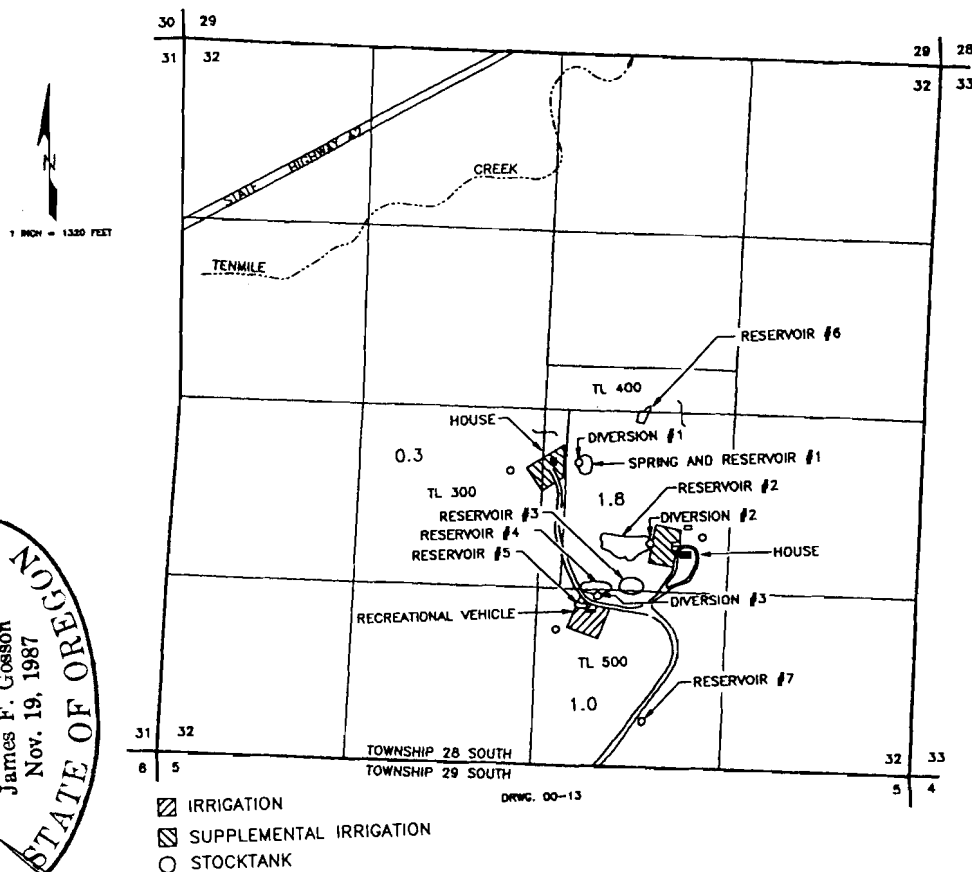

| DIVERSION | FT. N. | FT. W. | 1/4 1/4 |                                       |
|-----------|--------|--------|---------|---------------------------------------|
| POD #1    | 2240   | 2180   | NW SE   | ALL BEING FROM THE SOUTHEAST COR-     |
| POD #2    | 1670   | 1710   | NW SE   | NER OF SECTION 32, TOWNSHIP 28 SOUTH, |
| POD #3    | 1320   | 2070   | SW SE   | RANGE 7 WEST, W.M., DOUGLAS COUNTY.   |

THE PURPOSE OF THIS MAP IS TO IDENTIFY THE LOCATION OF THE WATER RIGHT. IT IS NOT INTENDED TO PROVIDE INFORMATION RELATIVE TO THE LOCATION OF PROPERTY OWNERSHIP BOUNDARY LINES.