


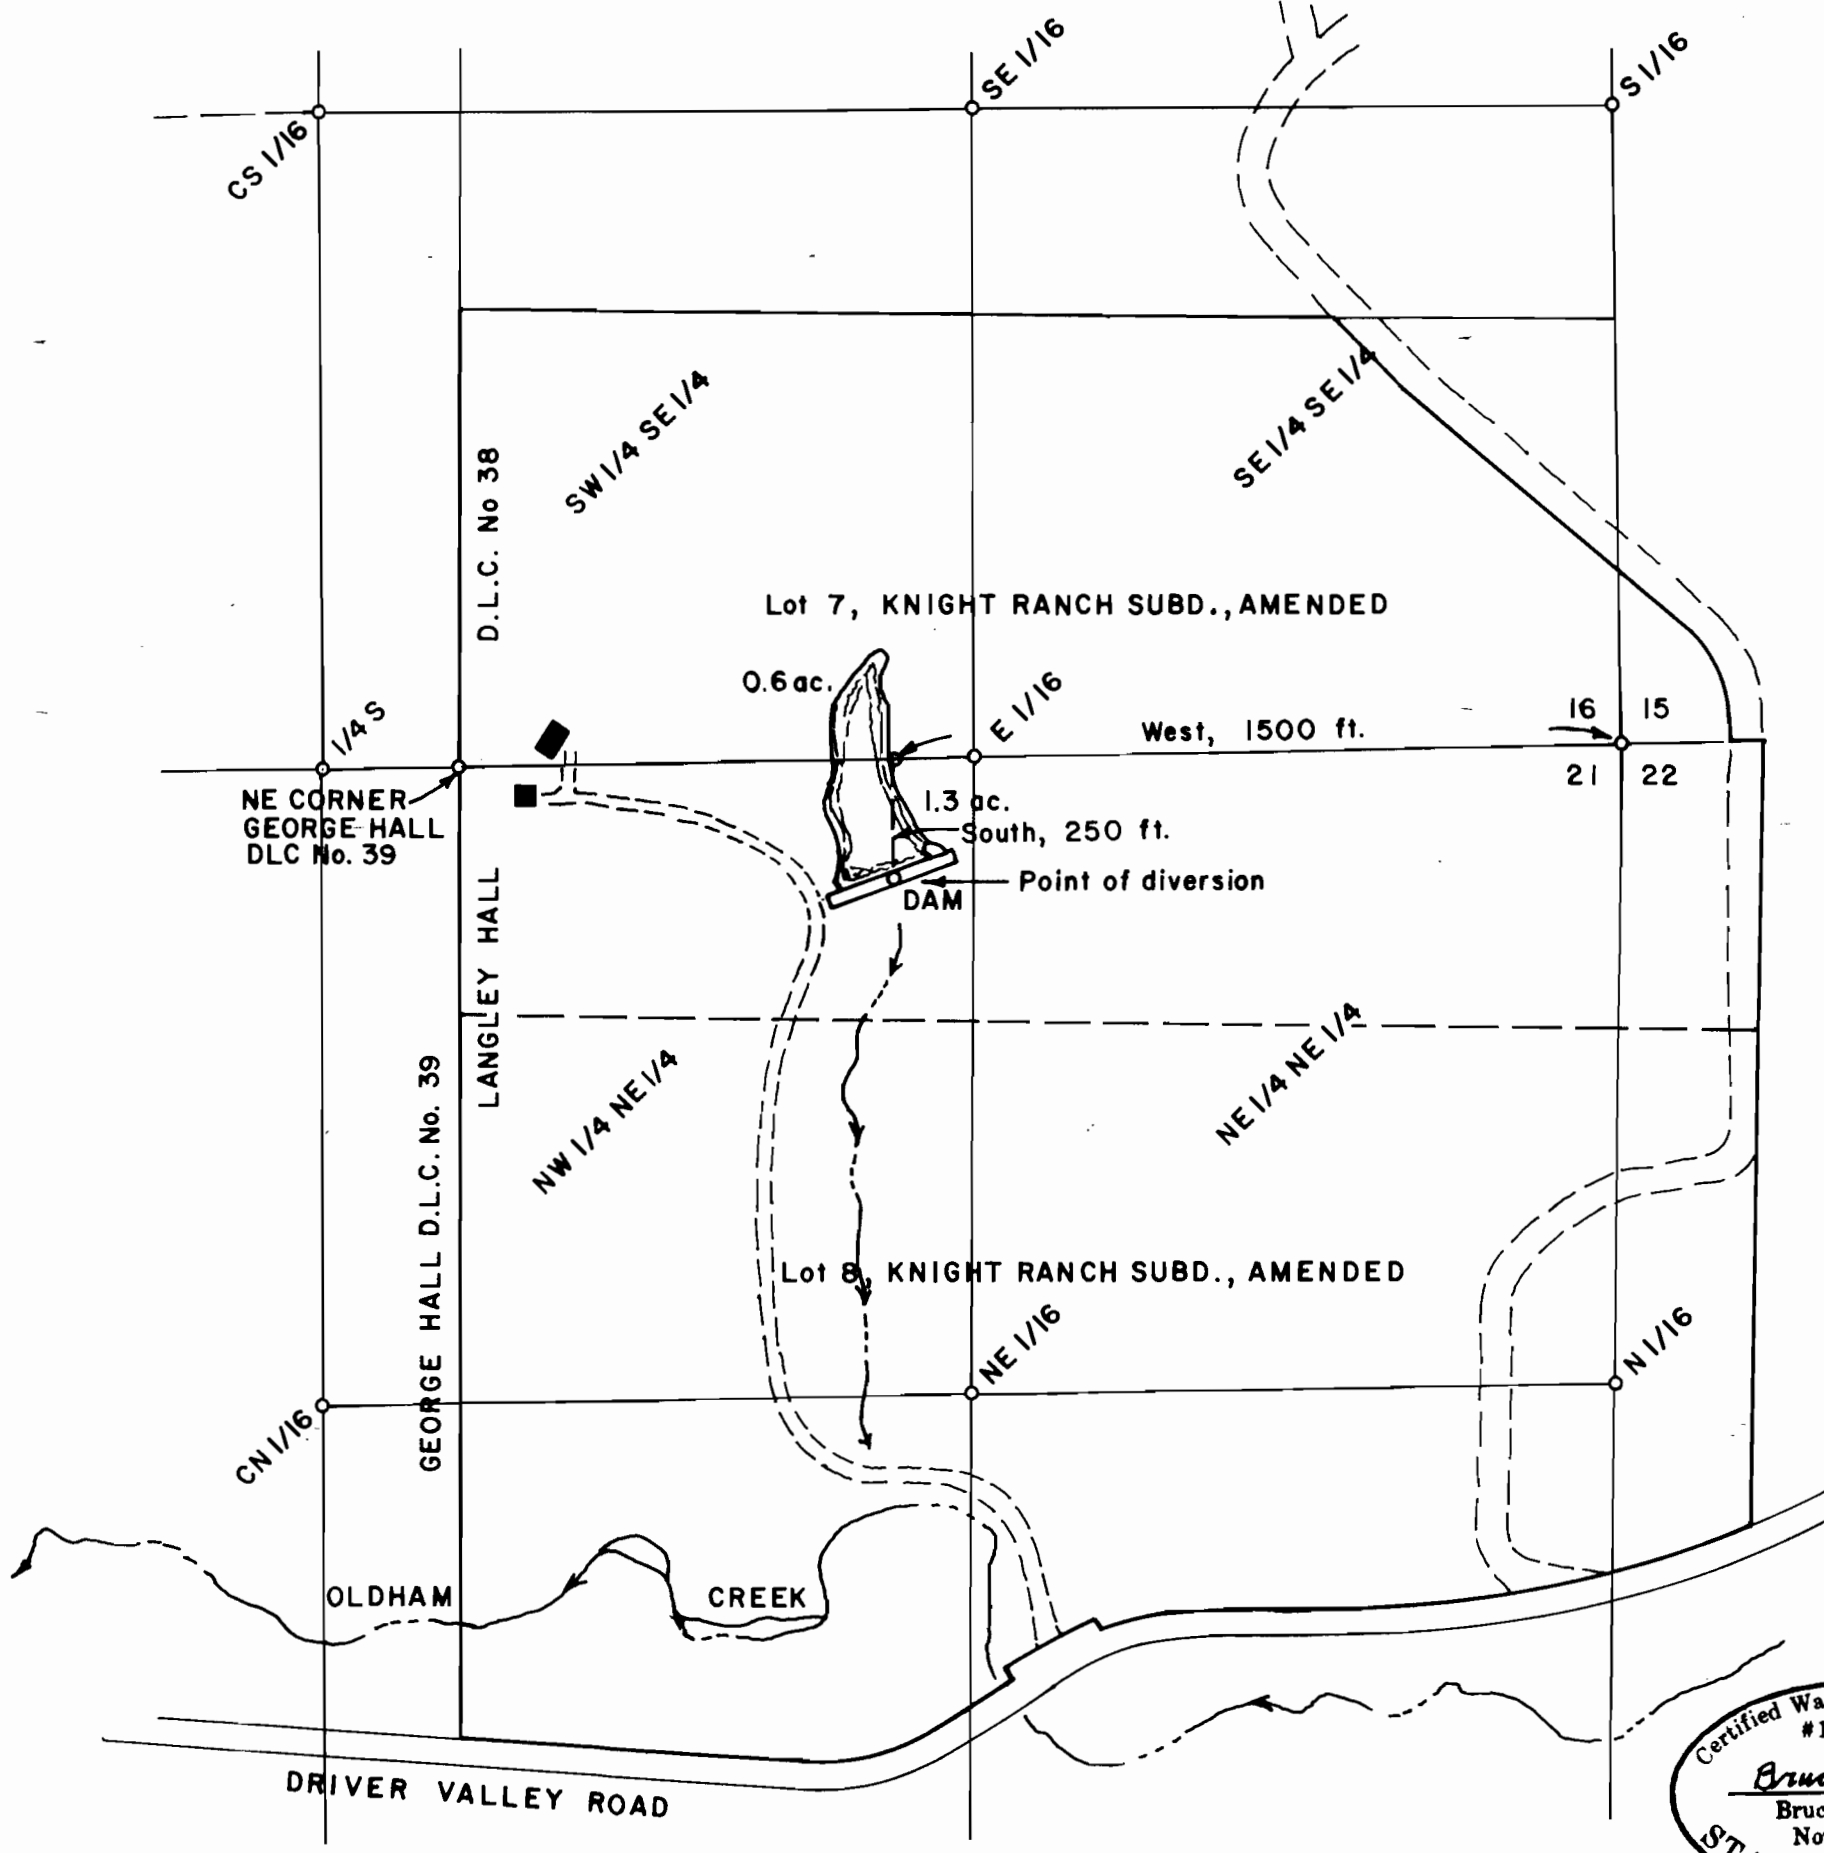

Scale 1" = 400 ft.

RECEIVED

SEP - 6 1996

WATER RESOURCES DEPT.
SALEM, OREGON

**FINAL PROOF SURVEY OF A
PERMIT TO CONSTRUCT A RESERVOIR
& APPROPRIATE SURFACE WATER IN
KNIGHT RANCH SUBDIVISION IN
SECTIONS 16 & 21, T24S, R4W, W.M.,
DOUGLAS COUNTY, OREGON**

Application No. R-71067 & S-71068
Permit No. R-11351 & 51192

For: Dr. Ronald Smelt
7250 Driver Valley Road
Oakland, Oregon 97462

By: Shaner Engineering, Inc.
P.O. Box 1430
Roseburg, Oregon 97470

August 14, 1996

