


RECEIVED

AUG 19 1999

WATER RESOURCES DEPT.
SALEM, OREGON

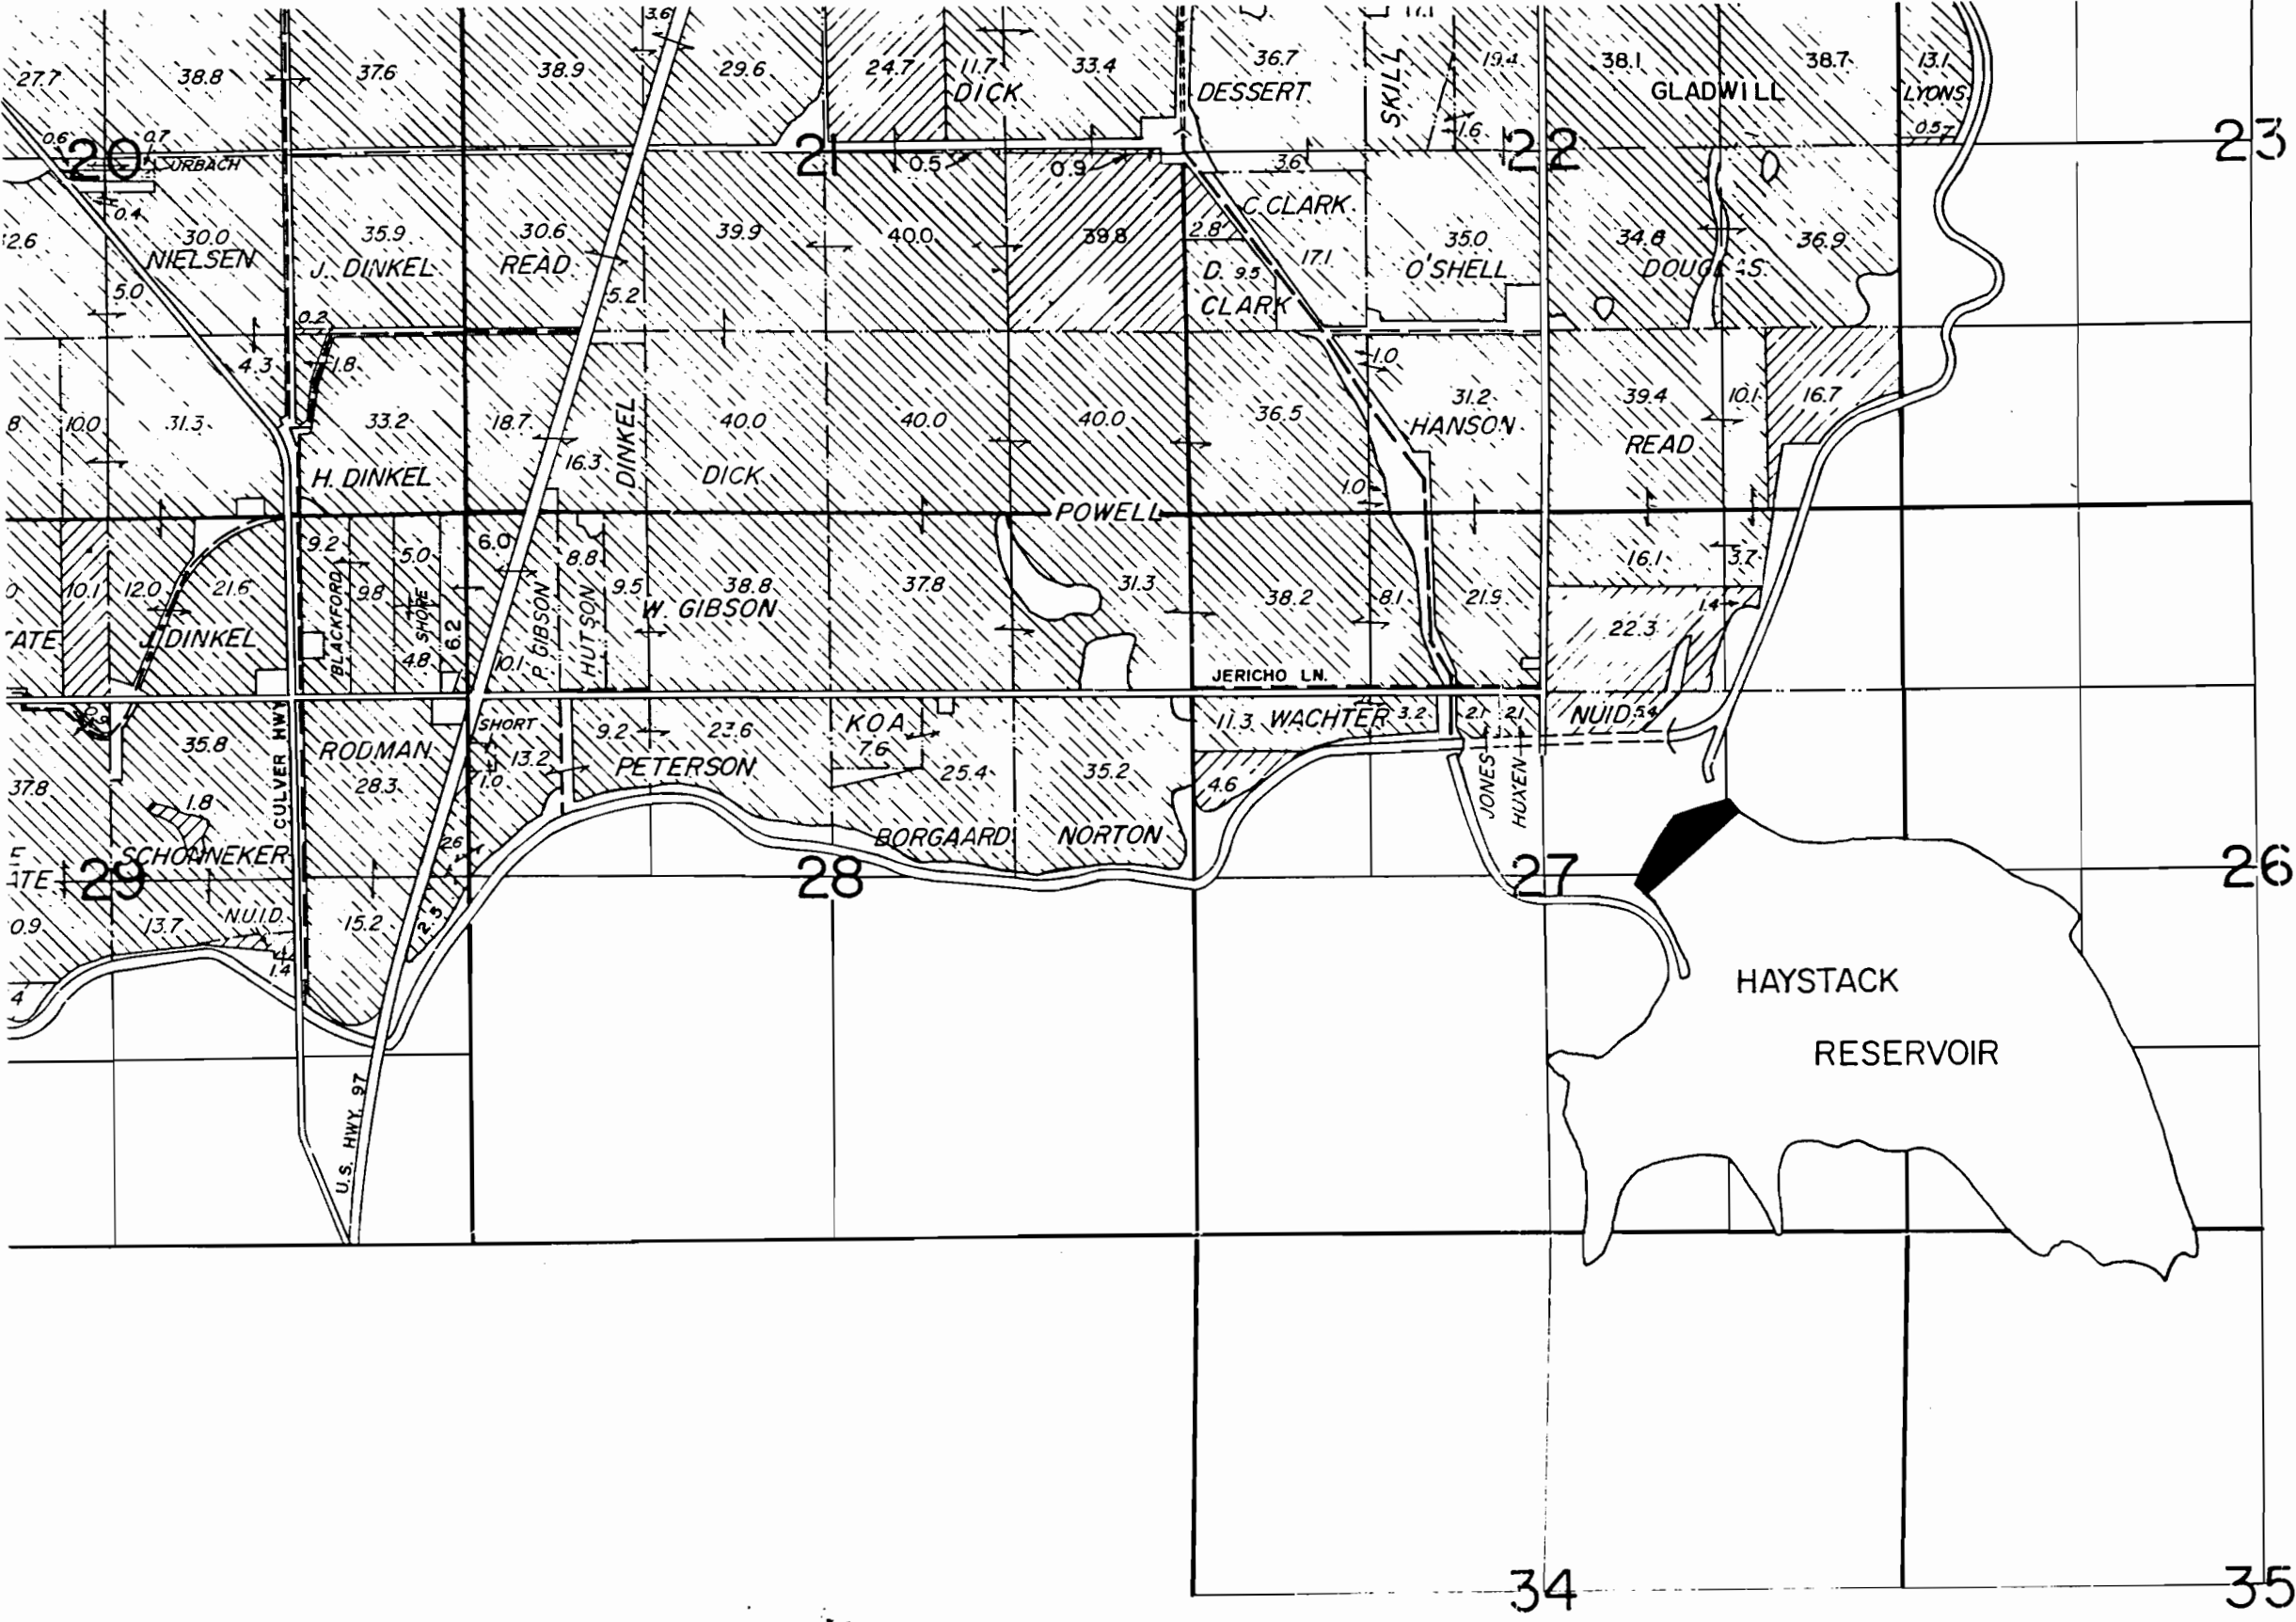

T. 12 S., R. 13 E., V.I.M.

Note: copied from Final Proof
Survey map made in
connection with
Permits R-1754
and 23196

permit R11857