

FINAL PROOF SURVEY FOR JOHN BAKOS

DAM AND RESERVOIR UNDER PERMIT #R-11412
SUPPLEMENTAL IRRIGATION UNDER PERMIT #51326
LOCATED IN SECTIONS 35 AND 36, T40S, R33E, W.M.
AND IN SECTIONS 2 AND 11, T41S, R33E, W.M.
HARNEY COUNTY, OREGON


WATER HOLDING AREA FOR WATER,
10" PIPE RUNS UNDER SMALL DIKE
AND IS CONNECTED INTO A CENTRIFUGAL
PUMP. A 6" LINE RUNS ACROSS THE
ROAD AND ATTACHES TO A 6" UNDERGROUND
LINE THAT RISES FOR WHEEL
LINE ATTACHMENT.

CENTRIFUGAL PUMP
15 HORSEPOWER
275 G.P.M.
S.N. B2172 T.P.M. 51624

POINT OF DIVERSION FOR
2' WIDE BY 8" DEEP DITCH,
2851 FEET SOUTH AND 2314 FEET
WEST OF THE NE CORNER OF
SECTION 2.

POINT OF DIVERSION FOR
2' WIDE BY 8" DEEP DITCH,
3193 FEET SOUTH AND 2711 FEET
WEST OF THE NE CORNER OF
SECTION 2.

POINT OF DIVERSION FOR
2' WIDE BY 8" DEEP DITCH,
3900 FEET SOUTH AND 2745 FEET
WEST OF THE NE CORNER OF
SECTION 2.

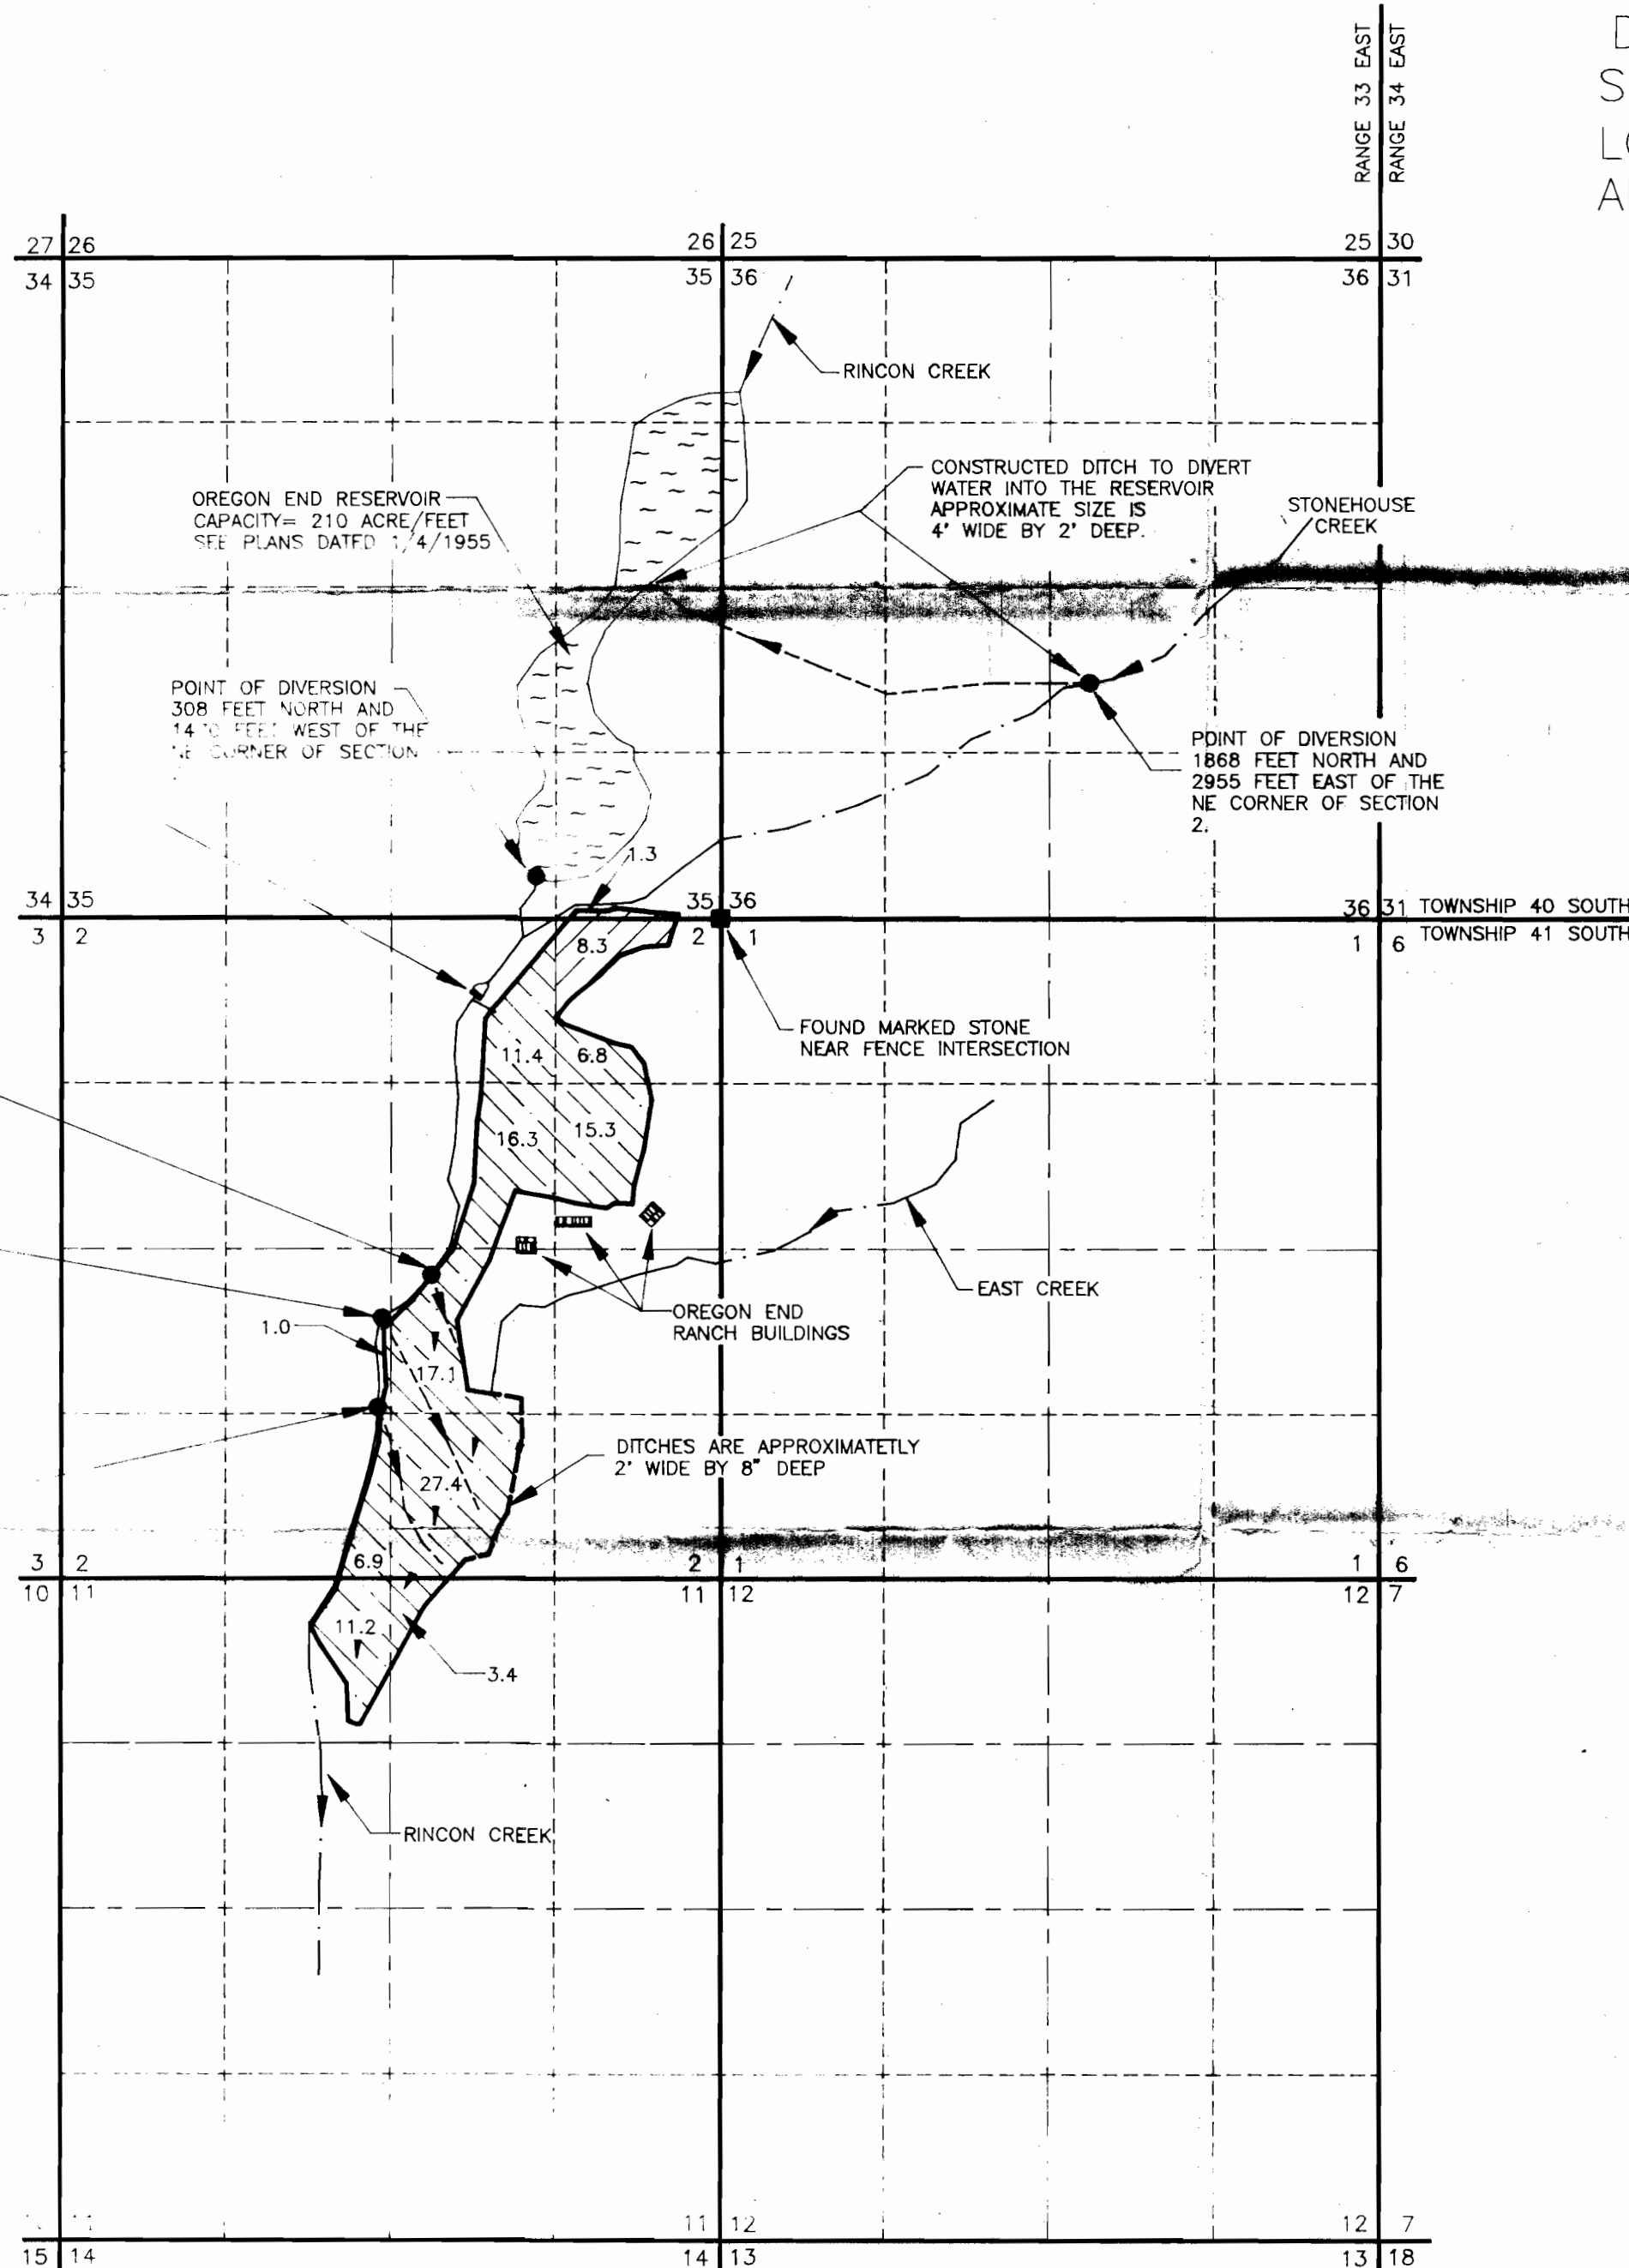


LEGEND

- SECTION LINE
- - - 1/4 SECTION LINE
- - - 1/16 SECTION LINE
- CREEK, NAME AS NOTED
- - - DITCH, SIZE AS NOTED
- DIVERSION POINTS AS NOTED
- DIRECTION OF FLOOD IRRIGATION
- FOUND MONUMENT AS NOTED
- ~~~~~ OREGON END RESERVOIR
- ▨ PRIMARY WATER RIGHT FROM RINCON CREEK AS PER PERMIT #23509.
116.8 ACRES OF SUPPLEMENTAL WATER RIGHTS UNDER PERMIT #51326
- ▨ AREA COVERED BY GROUND WATER PERMIT #G-9804,
RECOMMEND WATER FROM RESERVOIR BE PRIMARY AND
THE GROUND WATER BE SUPPLEMENTAL.

NOTE: PREPARATION OF THIS MAP IS FOR IDENTIFYING PROPOSED
WATER RIGHTS ONLY. IT HAS NO INTENT TO PROVIDE LOCATIONS
OR DIMENSIONS OF PROPERTY BOUNDARIES.

BEARINGS BASED ON SOLAR OBSERVATION

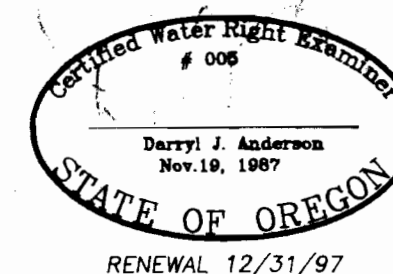

PREPARED FOR:
JOHN BAKOS
3805 HIGHWAY 65
LINCOLN, CA 95648
(916) 645-1616

PREPARED BY:
ANDERSON ENGINEERING AND SURVEYING
HC 64 BOX 24
P.O. BOX 28
LAKEVIEW, OREGON 97630
(503) 947-4407 FAX 947-2321
JOB #94091 DRAWING: 94091
MAY 1995 SHEET 1 OF 1

MAP REVISED 12/9/96