
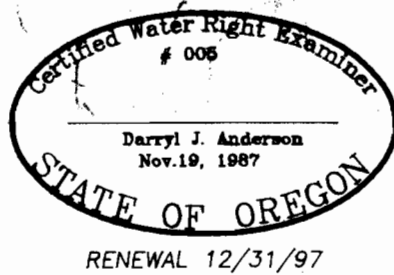


FINAL PROOF SURVEY FOR JOHN BAKOS

DAM AND RESERVOIR UNDER PERMIT #R-11412
SUPPLEMENTAL IRRIGATION UNDER PERMIT #51326
LOCATED IN SECTIONS 35 AND 36, T40S, R33E, W.M.
AND IN SECTIONS 2 AND 11, T41S, R33E, W.M.
HARNEY COUNTY, OREGON

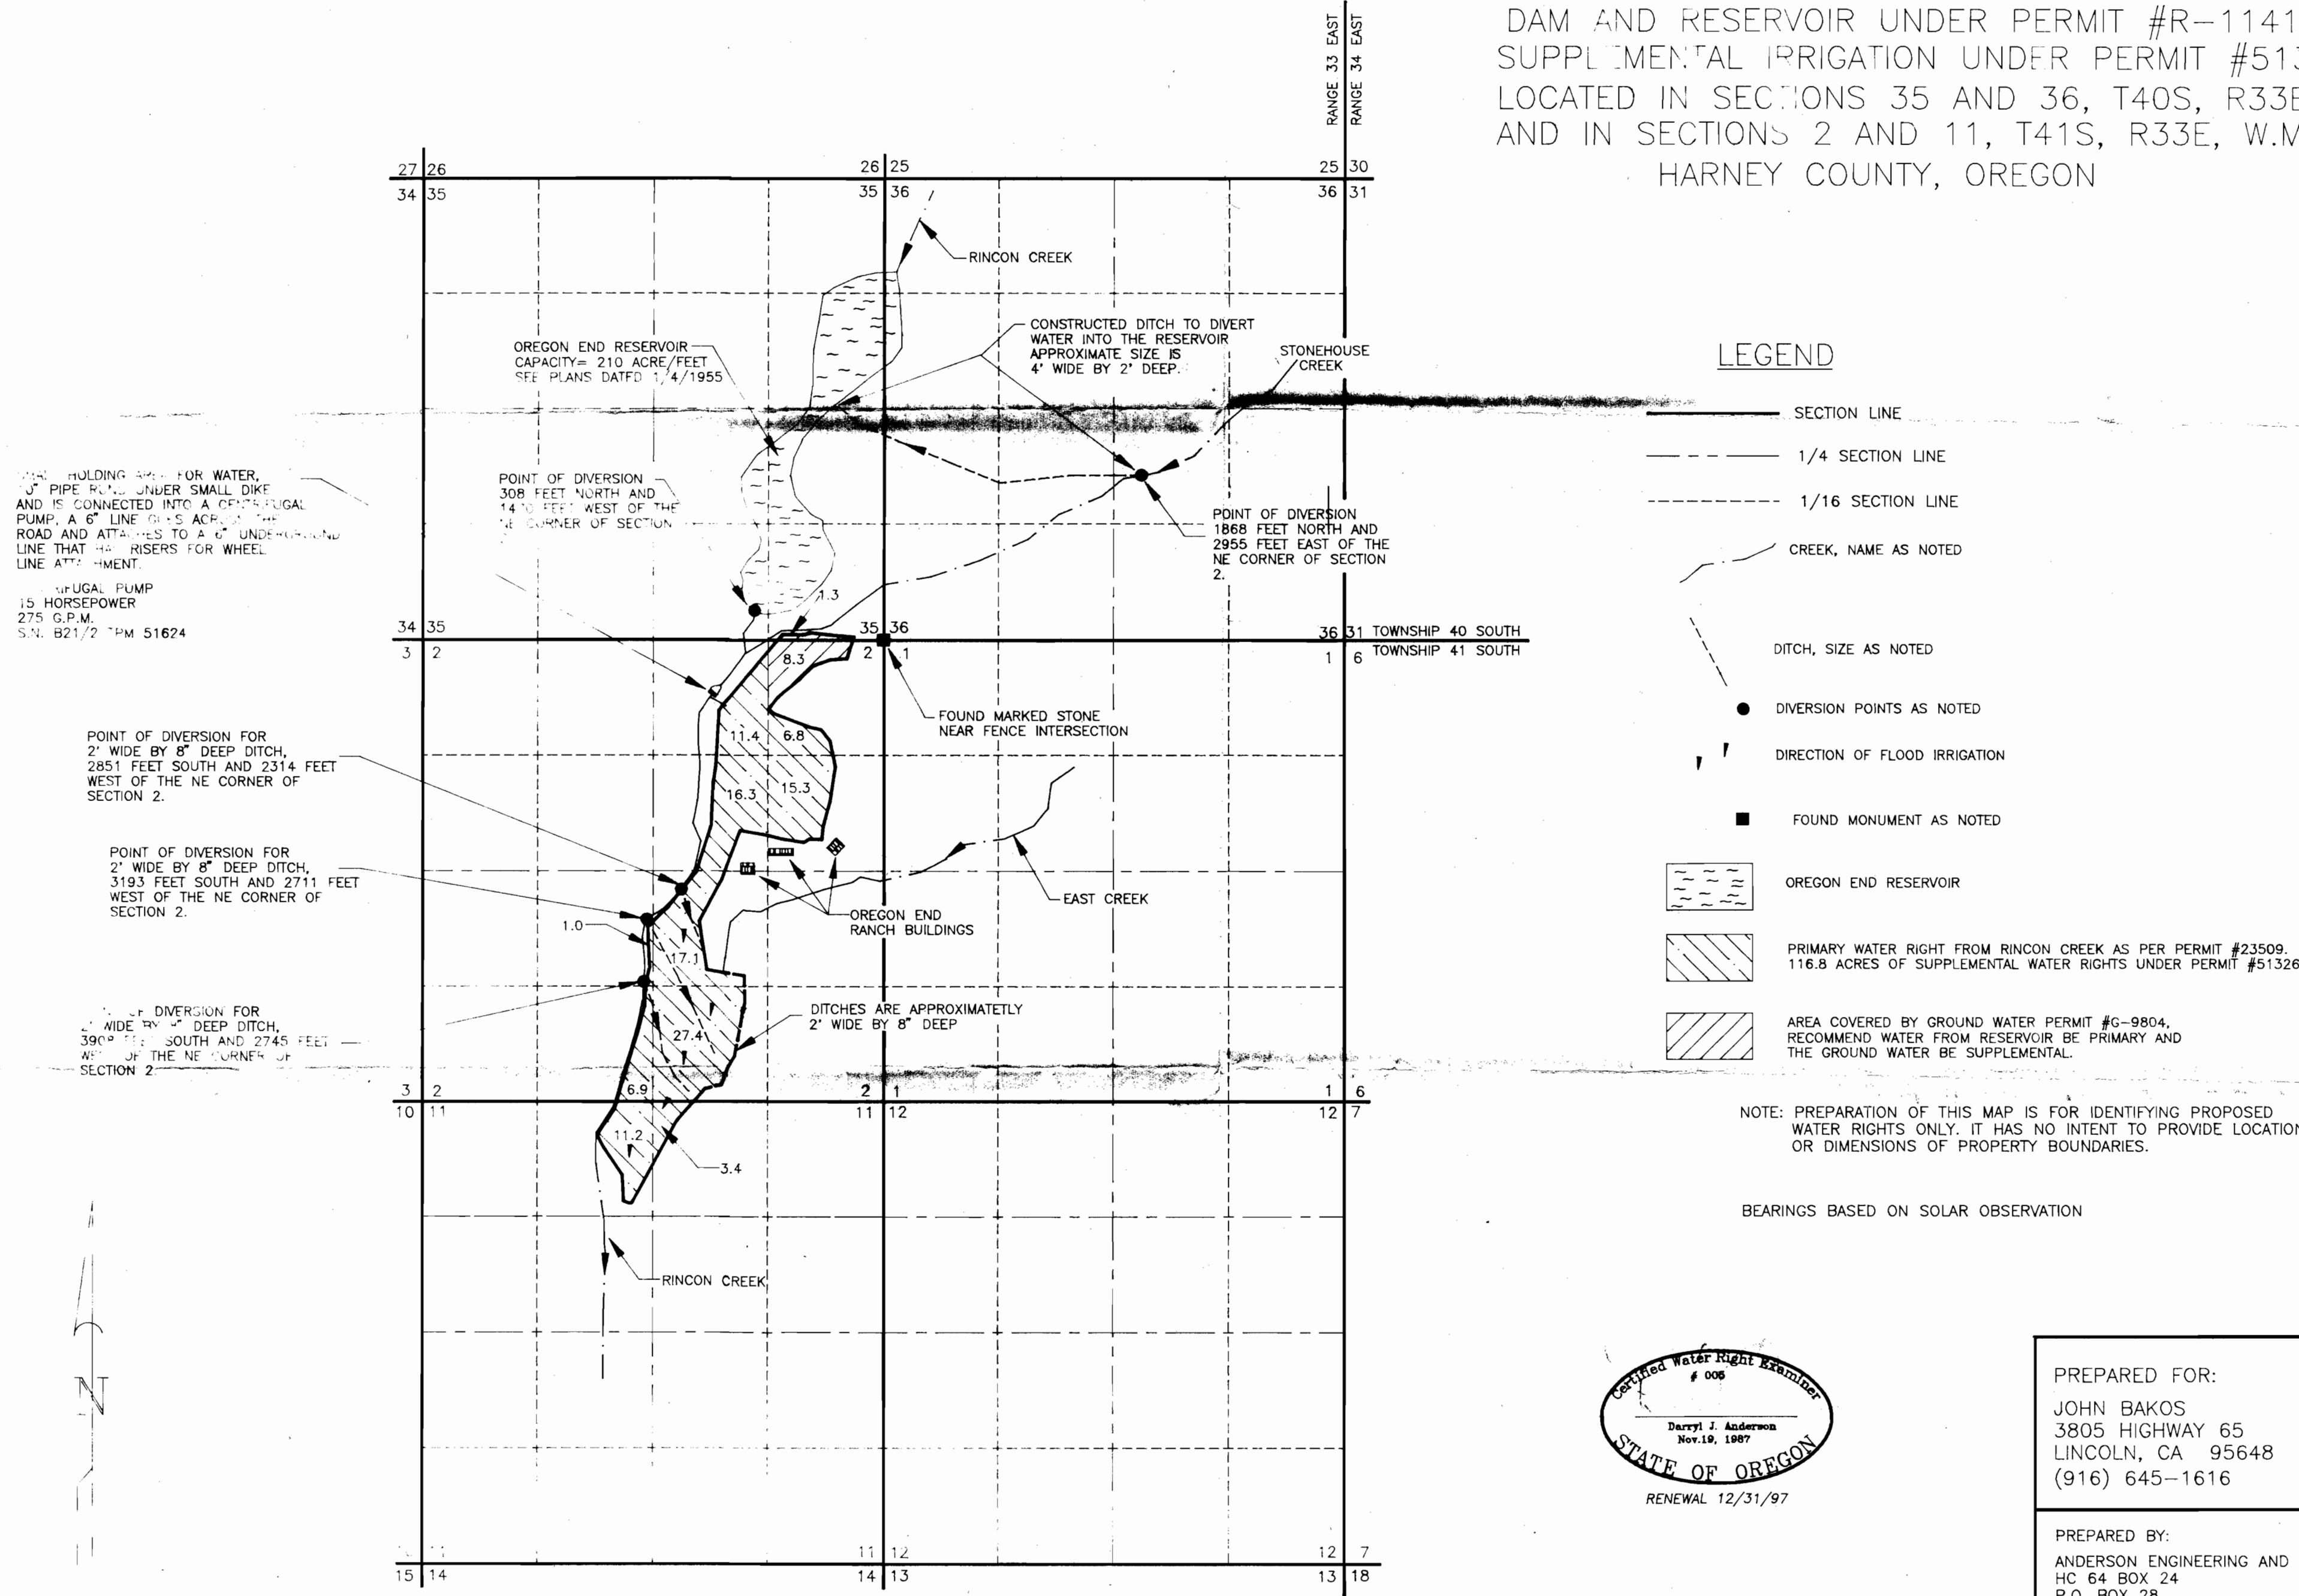

PREPARED FOR:
JOHN BAKOS
3805 HIGHWAY 65
LINCOLN, CA 95648
(916) 645-1616

PREPARED BY:
ANDERSON ENGINEERING AND SURVEYING
HC 64 BOX 24
P.O. BOX 28
LAKEVIEW, OREGON 97630
(503) 947-4407 FAX 947-2321
JOB #94091 DRAWING: 94091
MAY 1995 SHEET 1 OF 1