- Measuring point
- Automated Gauge
- PODs for S18547
- Government lot line
- Quarter quarter line
- Section line
- Tax lots
- Permit S18547
- Rivers
- Drainages

Warmsprings Canals and Pipelines

- Canal
- Lateral
- Drains
- Pipelines

Other District Canals

- Owyhee
- Owyhee Ditch Company
- VOID

Points of Diversion

POD 1 – Vines Canal – NW ¼ NE ¼ Section 4, T19S, R43E, W.M.; 284 feet South and 1608 feet West from NE Corner, Section 4.

POD 2 - JH Canal – NE ¼ NE ¼ Section 4, T19S, R43E, W.M.; 408 feet South and 1257 feet West from NE Corner, Section 4.

POD 3 – Farmers Canal – NW ¼ NE ¼ Section 4, T19S, R43E, W.M.; 78 feet South and 1337 feet West from NE Corner, Section 4.

POD 4 – GF Canal – SE ¼ NW ¼ Section 8, T19S, R44E, W.M.; 2643 feet South and 1809 feet East from NW Corner, Section 8.

POD 5 - Bully Creek Ditch – SW ¼ NE ¼ Section 4, T19S, R44E, W.M.; 2228 feet South and 1566 feet West from NE Corner, Section 4.

POD 6 - Bully Creek Exchange / Willow Creek Pump Canal – SW ¼ SW ¼ Section 19, T18S, R45E, W.M.; 223 feet North and 491 feet East from SW Corner, Section 19.

POD 7 – Nevada Canal – NE ¼ SW ¼ Section 21, T18S, R45E, W.M.; 1764 feet North and 1338 feet East from NE Corner, Section 21.

POD 8 – Willow Creek Feeder Canal – SW ¼ NW ¼ Section 31, T17S, R45E, W.M.; 2296 feet South and 476 feet East from NW Corner, Section 31.

POD 9 – Wood Drain / Blanton Drain – NE ¼ SE ¼ Section 13, T18S, R46E, W.M.; 1446 feet North and 53 feet West from SE Corner, Section 13.

Measuring Points

Namorf / Vines Gauges
Bully Creek Gauge
Willow Creek Gauge
1.Vines Ditch
2. J.H. Canal
3.Farmers Canal
3a. Kings Drain Inflow Measurements
3b. Eagle Pitcher Inflow Point
4. GF Canal
4a. Shelby's
4b. Bench Road
4c. Henry's Gulch
6. Bully Creek Exchange / Willow Creek Pump Canal
6a. Hale Road
6b. Willow Creek Pump Station
6c-1. Lateral 278
6c-2. Lateral 455
6d. End Owyhee Ditch
6e. Belnap farm
7. Nevada Canal19
7a. Morgan Lane
7b. Onion Avenue
7c. Shoestring Ditch
7d. Corn Drain
8. Willow Creek Feeder Canal
8a. 430 Lateral
8b. Dry Gulch
8c. Willow Creek Gauge

T17S, R44E, Section 24 · T17S, R44E, Section 25 · T17S, R44E, Section 30 · T17S, R44E, Section 31 · T17S, R44E, Section 36 · T18S, R44E, Section 1 · T18S, R44E, Section 6 · T18S, R44E, Section 7 · T18S, R45E, Section 8 · T18S, R45E, Section 12 · T18S, R45E, Section 7 · T18S, R45E, Section 8 · T18S, R45E, Section 9 · T18S, R45E, Section 10 · T18S, R45E, Section 11 · T18S, R45E, Section 12 · T18S, R45E, Section 7 · T18S, R45E, Section 13 · T18S, R45E, Section 14 · T18S, R45E, Section 15 · T18S, R45E, Section 16 · T18S, R45E, Section 17 · T18S, R45E, Section 18 · T18S, R45E, Section 19 · T18S, R45E, Section 20 · T18S, R45E, Section 21 · T18S, R45E, Section 22 · T18S, R45E, Section 23 · T18S, R45E, Section 24 · T18S, R45E, Section 25 · T18S, R45E, Section 26 · T18S, R45E, Section 27 · T18S, R45E, Section 28 · T18S, R45E, Section 29 · T18S, R45E, Section 30 · T18S, R46E, Section 1 · T18S, R46E, Section 6 · T18S, R46E, Section 7 · T18S, R46E, Section 8 · T18S, R46E, Section 9 · T18S, R46E, Section 10 · T18S, R46E, Section 11 · T18S, R46E, Section 12 · T18S, R46E, Section 13 · T18S, R46E, Section 14 · T18S, R46E, Section 15 · T18S, R46E, Section 16 · T18S, R46E, Section 17 · T18S, R46E, Section 18 · T18S, R46E, Section 19 · T18S, R46E, Section 20 · T18S, R46E, Section 21 · T18S, R46E, Section 22 · T17S, R47E, Section 29 · T17S, R47E, Section 31 · T17S, R47E, Section 32 · T18S, R47E, Section 5 · T18S, R47E, Section 7

Willow Creek · Lateral 455 · Lateral 278 · 430 Lateral · Owyhee Canal · Malheur River · Old Owyhee Ditch · Shoestring Canal · Mill Ditch · Nevada Upper Lift · Nevada Lower Lift · Wood Drain · Blanton Drain · Bully Creek · Hale Drain · Private Drain · Bench Road · Henry's Gulch · Cowboy Drain · Corn Drain · Airport

POD 1 · POD 2 · POD 3 · POD 4 · POD 5 · POD 6 · POD 7 · POD 8 · POD 9

MP 1 · MP 2 · MP 3 · MP 4a · MP 4b · MP 4c · MP 5 · MP 6 · MP 6a · MP 6b · MP 6c · MP 6d · MP 6e · MP 7 · MP 7a · MP 7b · MP 7c · MP 7d · MP 8a · MP 8b · MP 8c · MP 9

RECEIVED
JAN 09 2019
OWRD

CORI MAP # 1165(3)

OREGON WATER RIGHTS EXAMINER
RIGHT
NANCY L. RORICK
JULY 15, 2003
STATE OF OREGON
EXPIRES: 12/31/2020

N
0 660 1,320 Feet

This map is not intended to provide legal dimensions or locations of property ownership lines.

Final Proof Map (East)
Permit S18547, Application S18423, Priority 1939
Warmsprings Irrigation District
Vale, Oregon

map prepared by Nancy Rorick Consulting

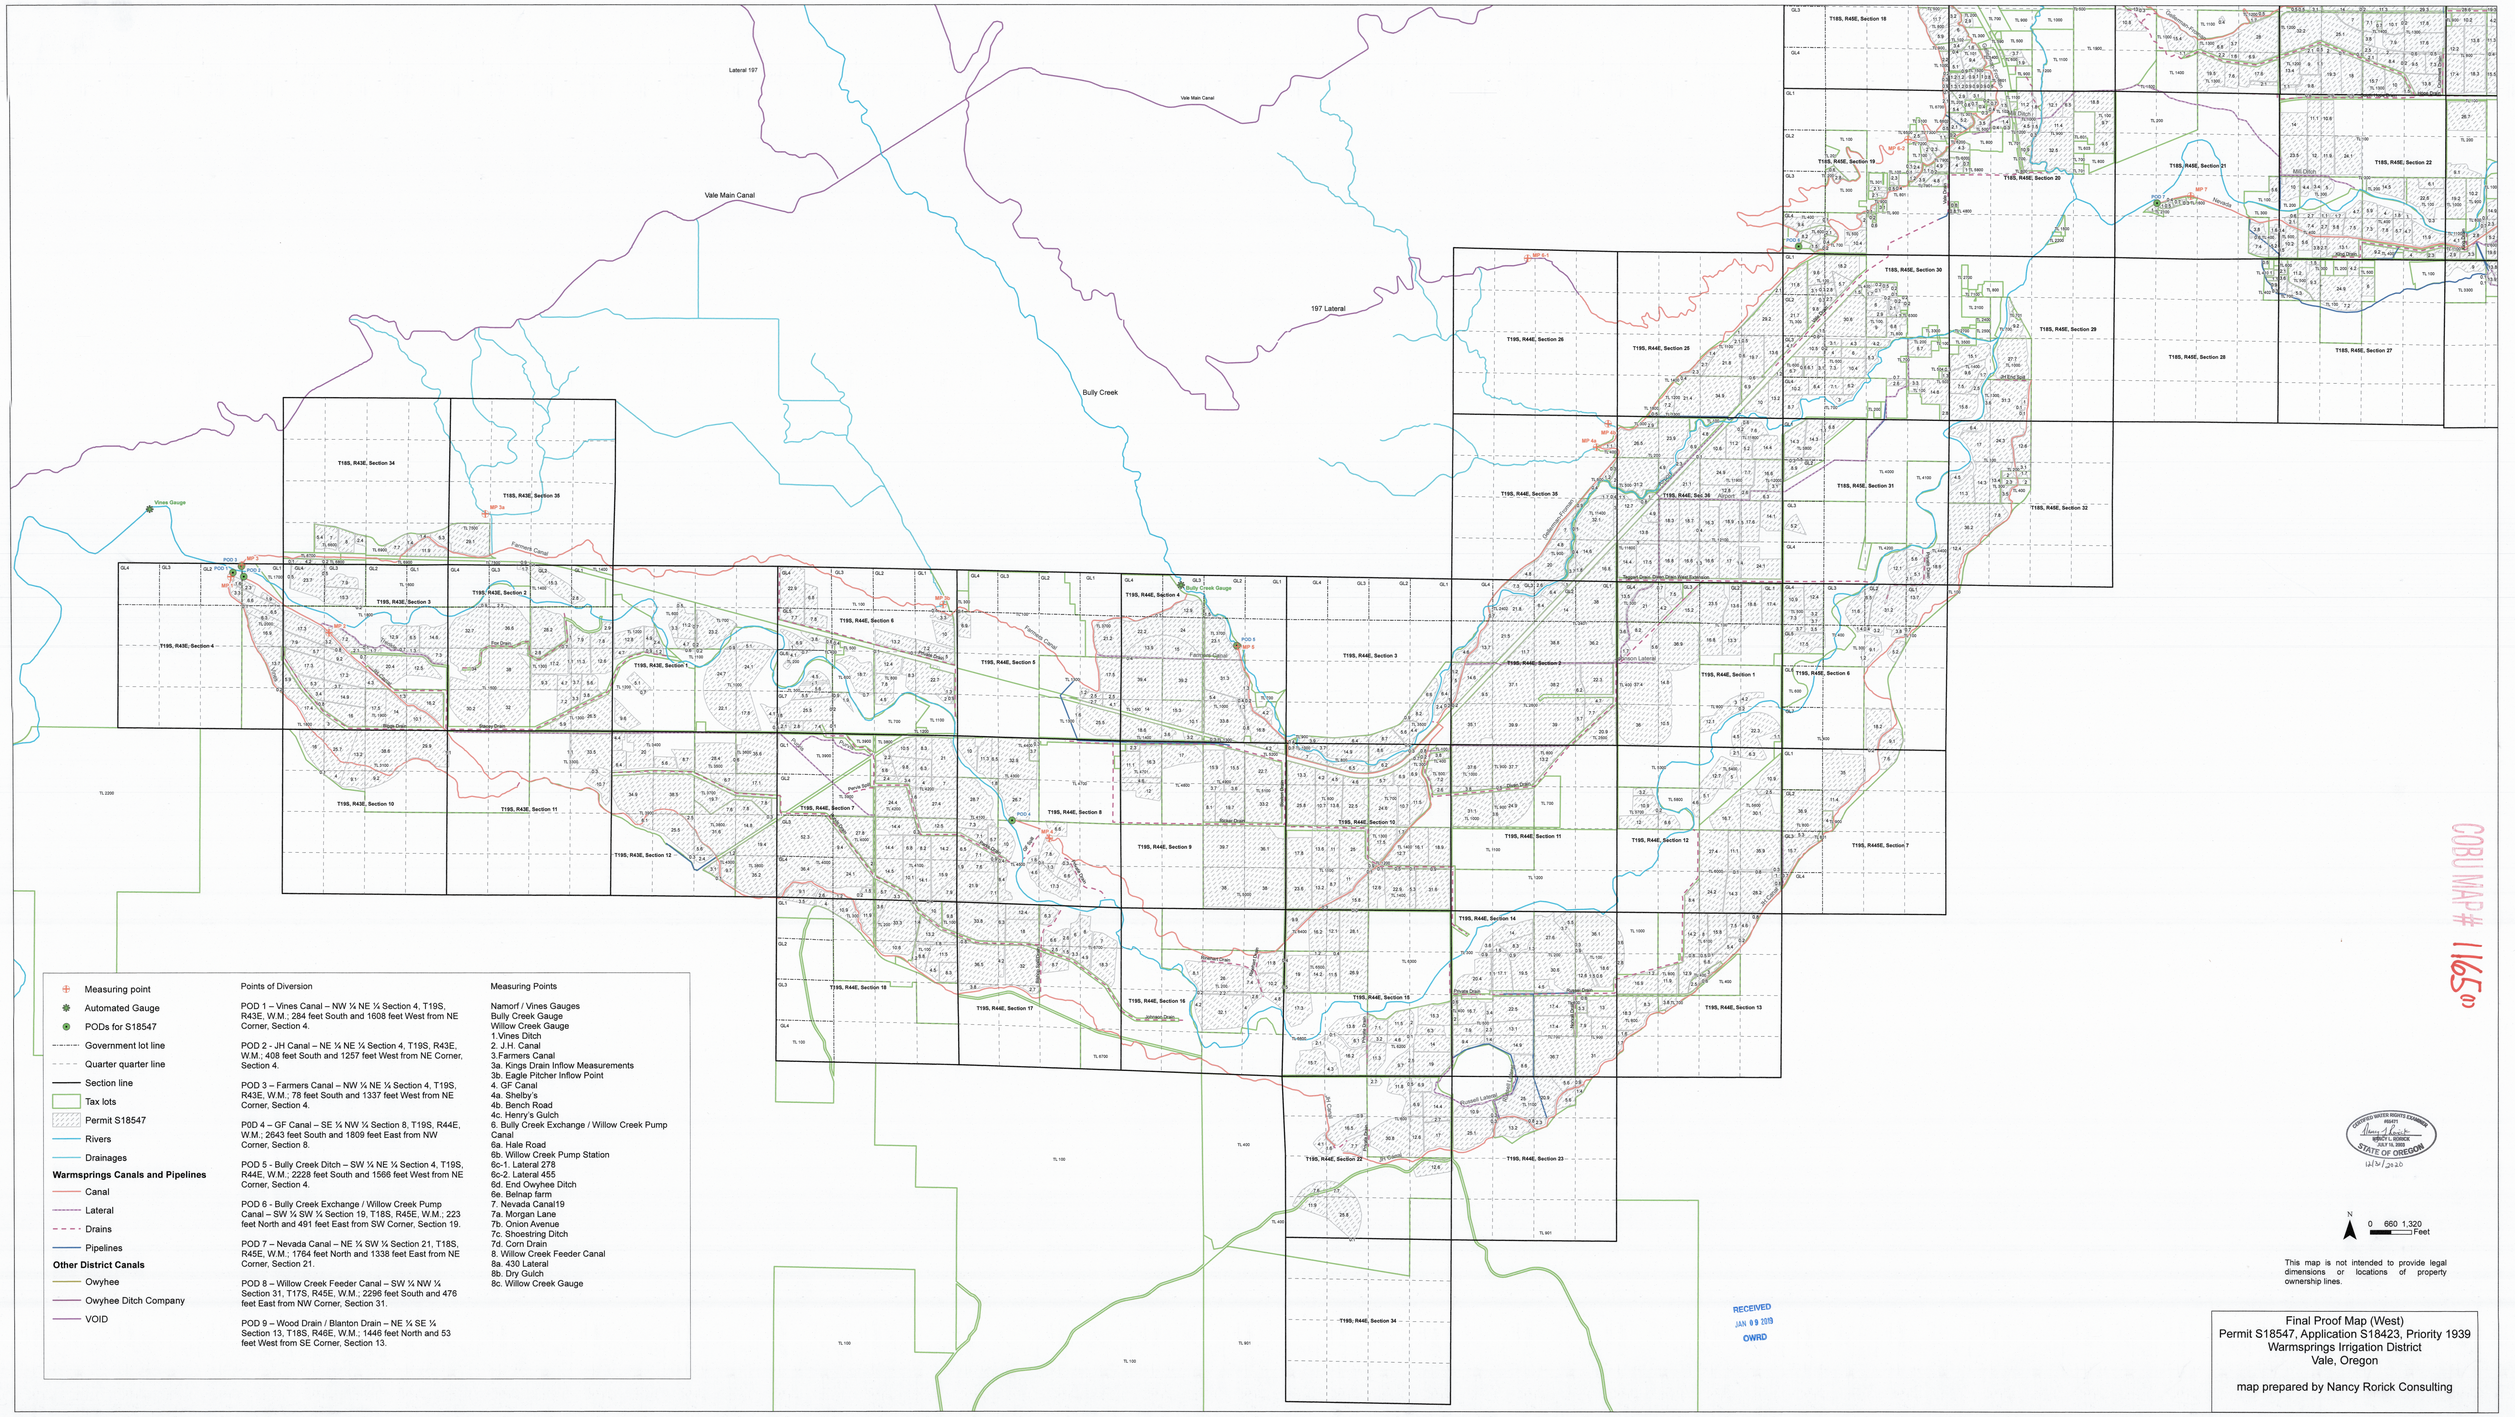
Lateral 197
Vale Main Canal
Vale Main Canal
197 Lateral
Bully Creek
Vines Gauge
MP 3a
MP 7
POD 1
POD 2
POD 3
POD 4
MP 4
MP 5
MP 6
MP 6-1
MP 8
MP 9
POD 5
POD 6
POD 7
POD 8
POD 9
Bully Creek Gauge
Namorf Canal
Farmers Canal
