

TO: Water Rights Section

August 14, 1997

FROM: Groundwater/Hydrology Section

Michael Zwart
Reviewer's Name

SUBJECT: Application G-14580

GROUNDWATER/SURFACE WATER CONSIDERATIONS

- 1. PER THE _____ Basin rules, one or more of the proposed POA's is/is not within _____ feet/mile of a surface water source (_____) and taps a groundwater source hydraulically connected to the surface water.
- 2. BASED UPON OAR 690-09 currently in effect, I have determined that the proposed groundwater use
 - a. ___ will, or _____ have the potential for substantial interference with the nearest
 - b. ___ will not _____ surface water source, namely _____; or
 - c. will if properly conditioned, adequately protect the surface water from interference:
 - i. The permit should contain condition #(s) 7B;
 - ii. ___ The permit should contain special condition(s) as indicated in "Remarks" below;
 - iii. ___ The permit should be conditioned as indicated in item 4 below; or
 - d. ___ will, with well reconstruction, adequately protect the surface from substantial interference.

GROUNDWATER AVAILABILITY CONSIDERATIONS

- 3. BASED UPON available data, I have determined that groundwater for the proposed use
 - a. ___ will, or _____ likely be available in the amounts requested without injury to prior rights
 - b. ___ will not _____ and/or within the capacity of the resource; or
 - c. will if properly conditioned, avoid injury to existing rights or to the groundwater resource:
 - i. The permit should contain condition #(s) 7A+; 7B
 - ii. ___ The permit should contain special condition(s) as indicated in "Remarks" below;
 - iii. ___ The permit should be conditioned as indicated in item 4 below; or
- 4.
 - a. ___ THE PERMIT should allow groundwater production from no deeper than ___ ft. below land surface;
 - b. ___ The permit should allow groundwater production from no shallower than ___ ft. below land surface;
 - c. ___ The permit should allow groundwater production only from the _____ groundwater reservoir between approximately _____ ft. and _____ ft. below land surface;
 - d. ___ Well reconstruction is necessary to accomplish one or more of the above conditions.
 - e. ___ One or more POA's commingle 2 or more sources of water. The applicant must select one source of water per POA and specify the proportion of water to be produced from each source.

REMARKS: Use non-seasonal use condition 7A

G-14580

(Well Construction Considerations on Reverse Side)

WELL CONSTRUCTION (If more than one well doesn't meet standards, attach an additional sheet.)

5. THE WELL which is the point of appropriation for this application does not meet current well construction standards based upon:
- a. ___ review of the well log;
 - b. ___ field inspection by _____;
 - c. ___ report of CWRE _____;
 - d. ___ other: (specify) _____

6. THE WELL construction deficiency:
- a. ___ constitutes a health threat under Division 200 rules;
 - b. ___ commingles water from more than one groundwater reservoir;
 - c. ___ permits the loss of artesian head;
 - d. ___ permits the de-watering of one or more groundwater reservoirs;
 - e. ___ other: (specify) _____

7. THE WELL construction deficiency is described as follows: _____

8. THE WELL
- a. ___ was, or constructed according to the standards in effect at the time of
 - b. ___ was not original construction or most recent modification.
 - c. ___ I don't know if it met standards at the time of construction.

RECOMMENDATION:

- A. ___ I recommend including the following condition in the permit:
"No water may be appropriated under terms of this permit until the well(s) has been repaired to conform to current well construction standards and proof of such repair is filed with the Enforcement Section of the Water Resources Department."
- B. ___ I recommend withholding issuance of the permit until evidence of well reconstruction is filed with the Enforcement Section of the Water Resources Department.
- C. ___ REFER this review to Enforcement Section for concurrence.

THIS SECTION TO BE COMPLETED BY ENFORCEMENT PERSONNEL

I concur in G/H's recommendation A or B above relating to conditioning or withholding the permit
_____, 199__
(Signature)

I do not concur in G/H's recommendation A or B above relating to conditioning or withholding the permit for the following reasons: _____

_____, 199__
(Signature)

STATE OF OREGON
WATER RESOURCES DEPARTMENT

INTEROFFICE MEMO

To: FILE

Date: August 14, 1997

From: MICHAEL ZWART


Subject: APPLICATION G-14580, WASCO COUNTY, JUDGE JOHN MABREY

This application proposes to use 500 gpm of groundwater from one well for municipal use. The well is constructed to a depth of 603 feet and penetrates a confined aquifer developed in basalts of the Columbia River Basalt Group.

The well is located about 2800 feet from the Columbia River and about 1200 feet from Gooseberry Creek. The aquifer penetrated is not likely in hydraulic connection with Gooseberry Creek or the nearby reach of the Columbia River, but may be at a greater distance downstream. There is no potential for substantial interference with the surface water sources, based on the aquifer penetrated and the distance.



Permit conditions 7A (non-seasonal use) and 7B are recommended.

WASC 50145

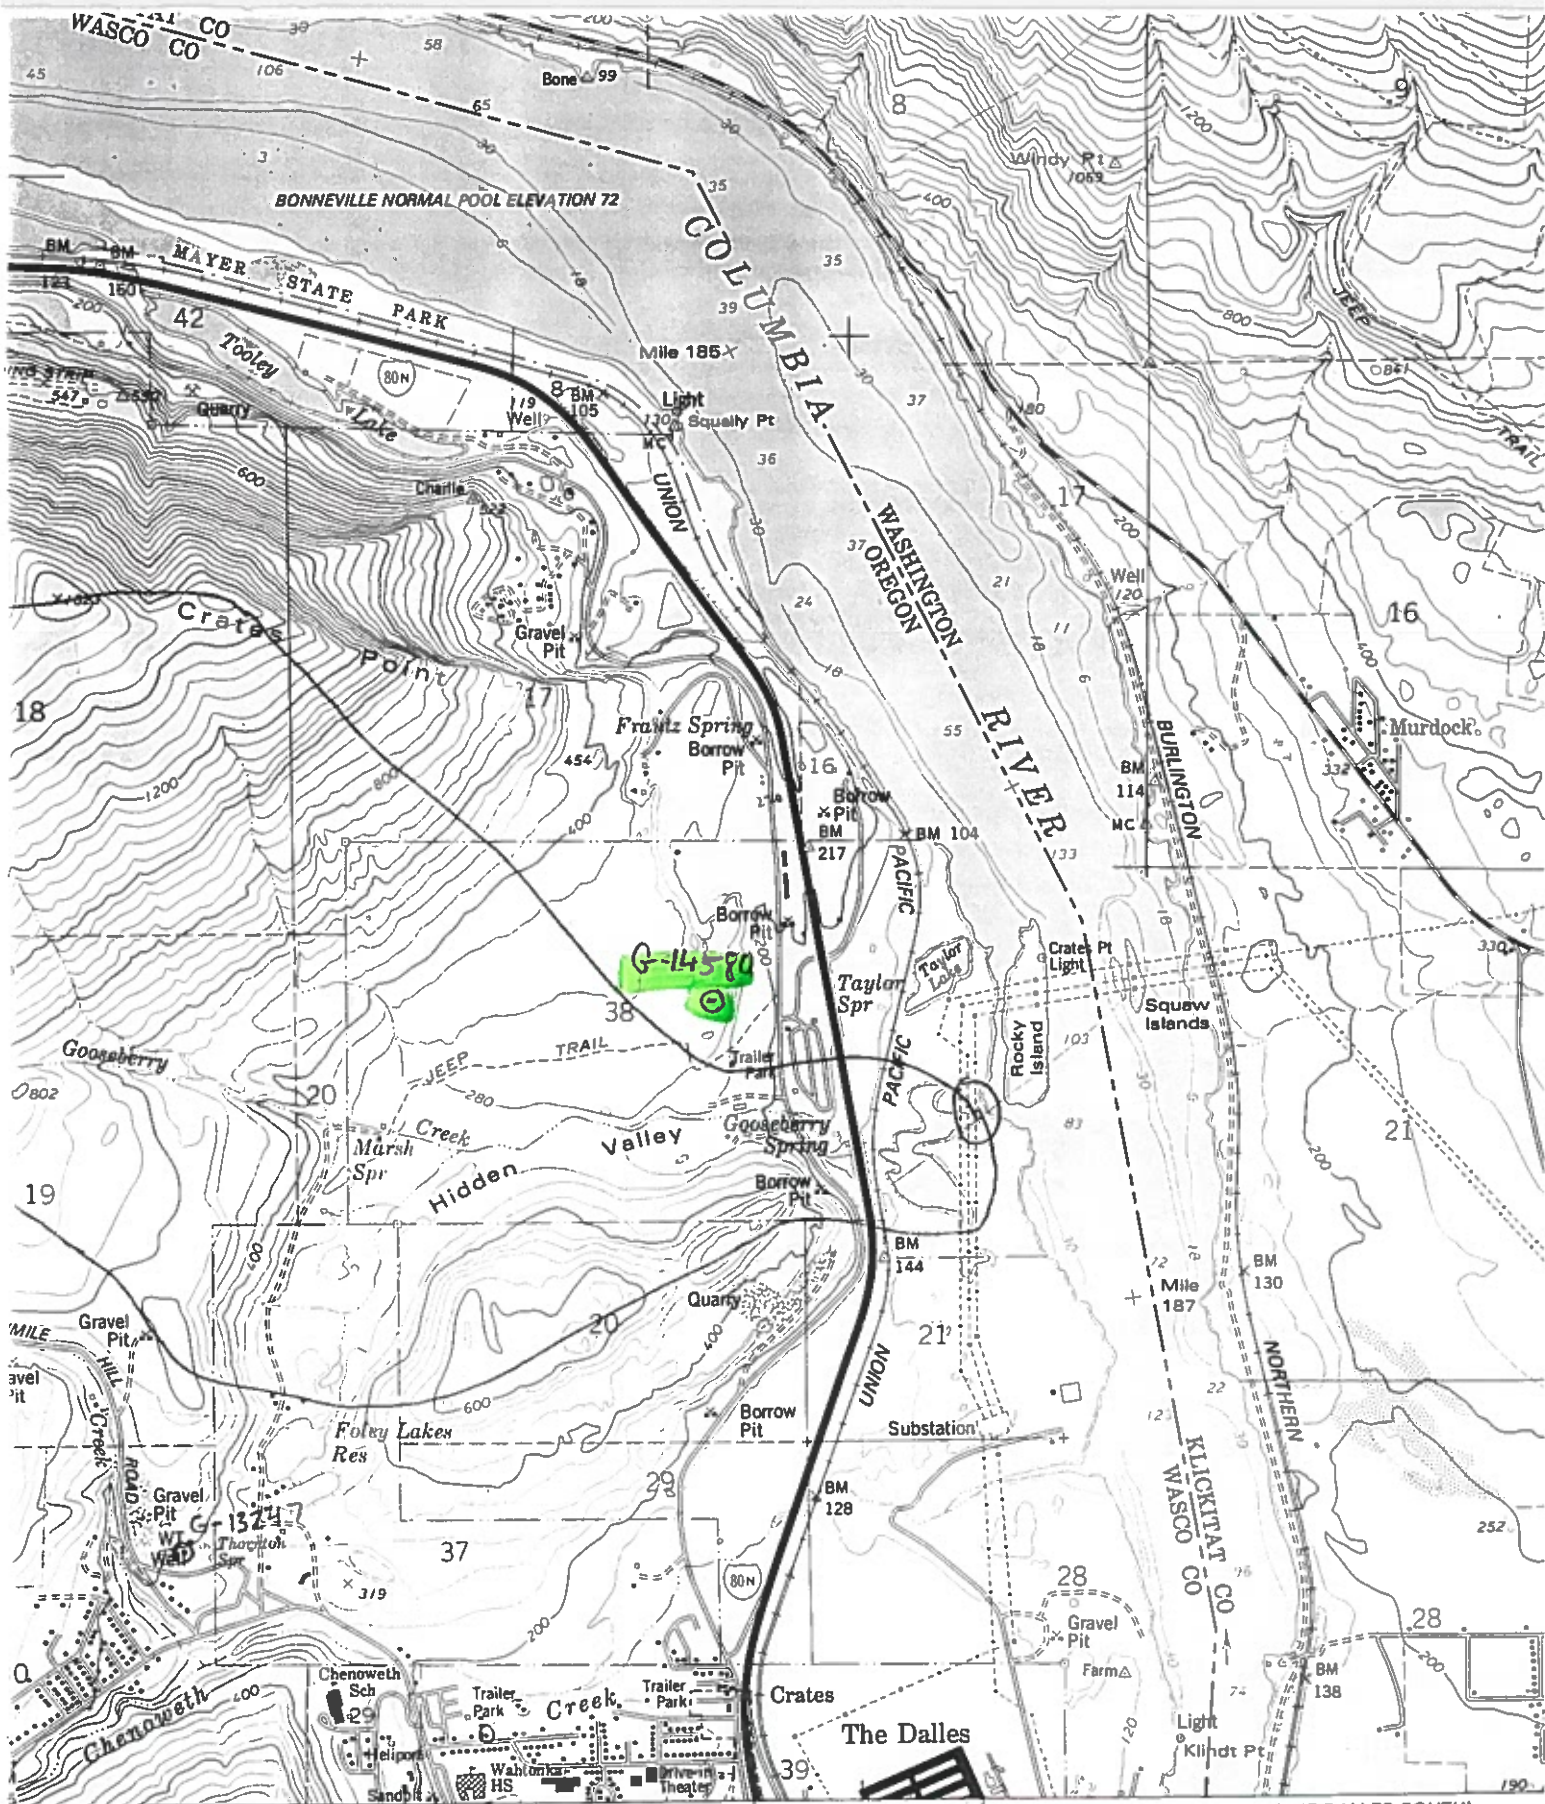

1 810 000 FEET (WASH.) *38 CIVIC CENTER EXIT 1.5 MI. ARLINGTON 57 MI. 12'30" R 13 E (THE DALLES SOUTH) 1775 N SW


and published by the Geological Survey
 and NOS/NOAA
 photogrammetric methods from aerial
 1973. Field checked 1974
 data compiled from NOS/NOAA Chart 6157 (1973)
 not intended for navigational purposes
 geogon coordinate system, south zone

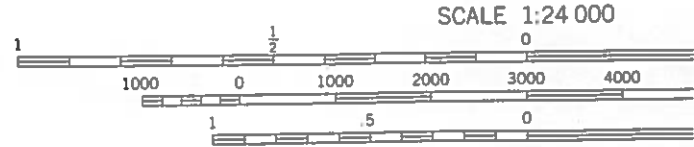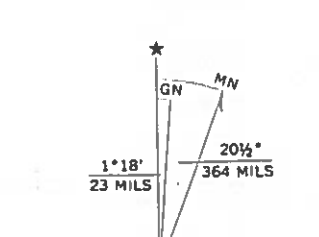

SCALE 1:24 000
 CONTOUR INTERVAL 40 FEET
 NATIONAL GEODETIC VERTICAL DATUM (NVD)
 DEPTH CURVES AND SOUNDINGS IN FEET—DATUM IS BONNEVILLE NORMAL POOL ELEVATION 72

Wells in the vicinity of application G 14580

- Application well(s) in this 1/4-1/4 section
- Well(s) identified in this section from OWRD's well log database within 1 mi. radius of application well(s)
- Well(s) identified in this 1/4-1/4 section from OWRD's well log database within 1 mi. radius of application well(s)
- ✱ Permitted well(s) in this 1/4-1/4 section within 1 mi. radius of application well(s)
- Conditioned, permitted well(s) in this 1/4-1/4 section within 5 mi. radius of application well(s)
- ▲ OWRD Observation well and well-ld within 5 mi. radius of application well(s)
- Critical GW Area
- - - Regulated GW Area

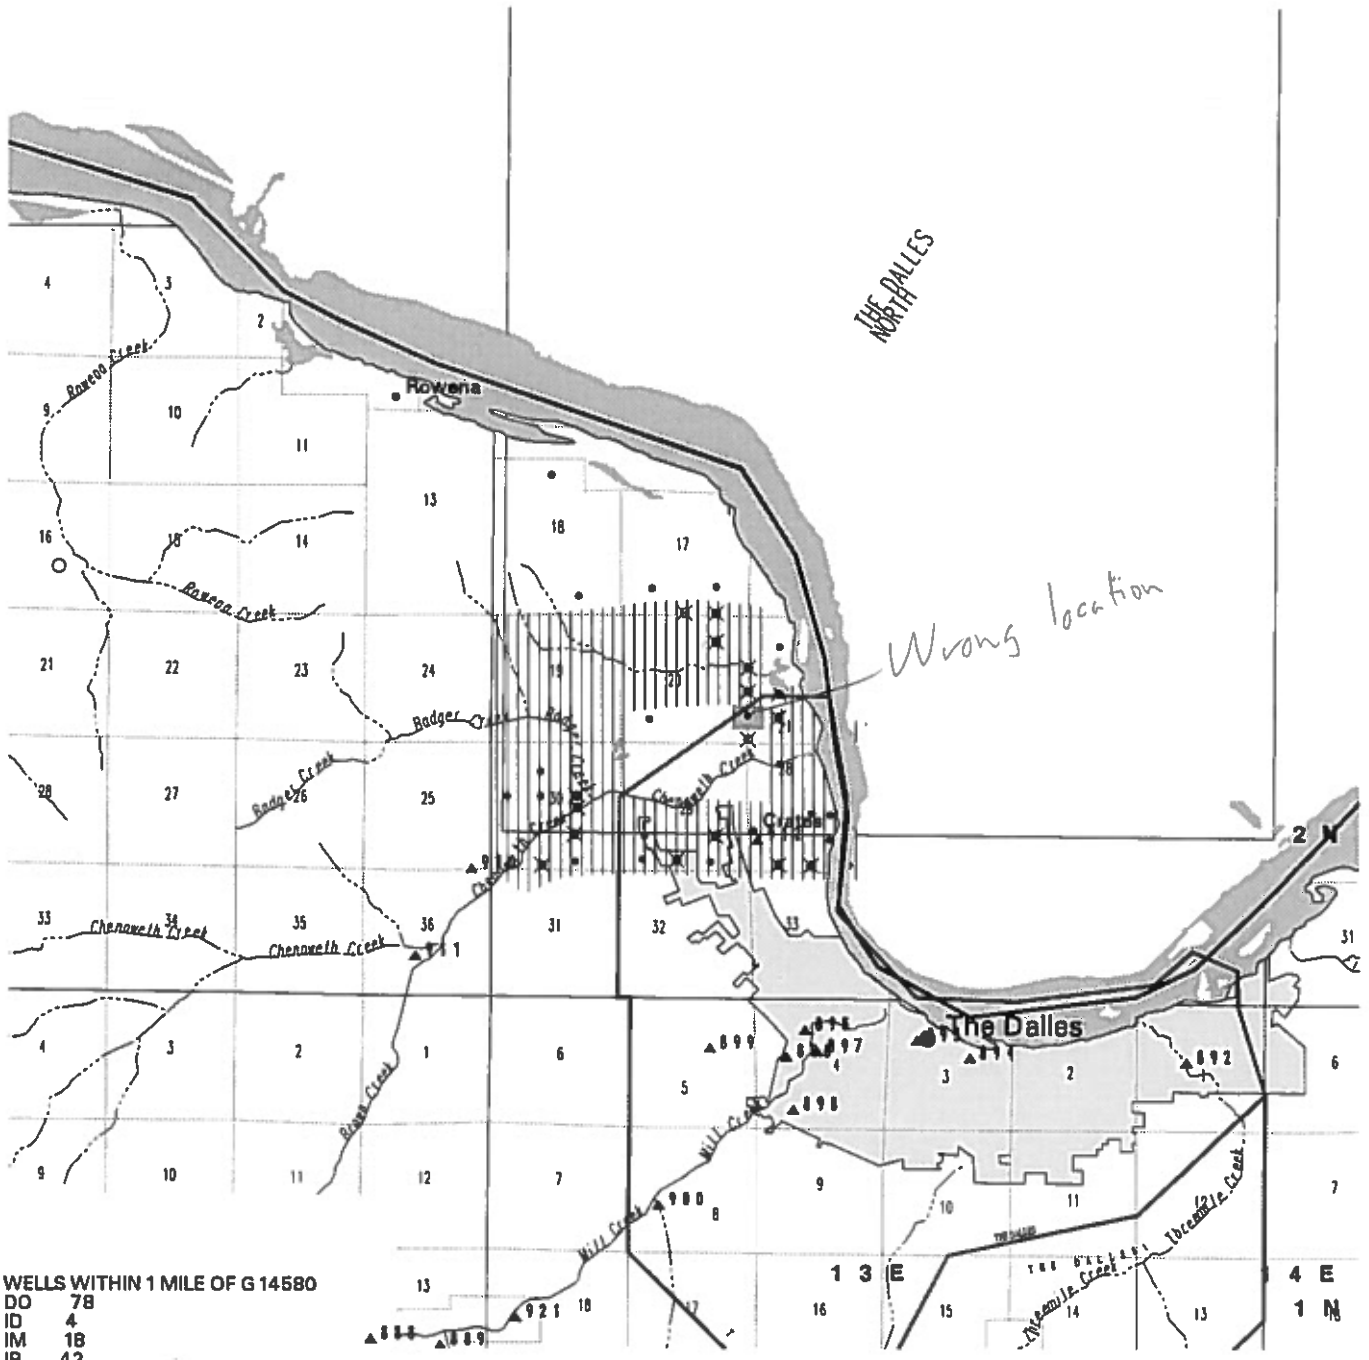

WELLS WITHIN 1 MILE OF G 14580

DO	78
ID	4
IM	18
IR	42
MO	108
MU	8

PERMITTED WELLS WITHIN 1 MILE OF APPLICATION G 14580

\$RECNO	APPLICATION	PERMIT	LOC-QQ	USE	RATE	DIV-UNITS
1	G	3204	G 2942	2.00N13.00E17NENW DO	0.0400	C
2	G	3204	G 2942	2.00N13.00E17NENE DO	0.0200	C
3	G	13515	G 12667	2.00N13.00E17SWNE IR	0.0120	C
3	G	13515	G 12667	2.00N13.00E17SWNE IR	0.1740	C
4	G	5674	G 5495	2.00N13.00E17NESE IS	0.5000	C
4	G	11519	G 10645	2.00N13.00E17NESE IR	0.0100	C
4	G	11519	G 10645	2.00N13.00E17NESE IR	0.0300	C
4	U	154	U 145	2.00N13.00E17NESE IR	0.0125	C
5	G	11519	G 10645	2.00N13.00E17SESE IR	0.0100	C
5	G	11519	G 10645	2.00N13.00E17SESE IR	0.0300	C
5	GR	4184	GR 3743	2.00N13.00E17SESE IR	400.0000	G
6	G	11053	G 10355	2.00N13.00E16SWSW IM	80.0000	G
7	G	5025	G 4732	2.00N13.00E21NWNW DO	0.0500	C
7	G	8256	G 7682	2.00N13.00E21NWNW IR	0.0700	C
8	G	11195	G 10309	2.00N13.00E20SENE IR	0.1700	C
9	G	7287	G 6714	2.00N13.00E19SWSE IR	0.0700	C
10	G	2467	G 2278	2.00N13.00E30WNE DO	0.1700	C
10	G	9705	G 9968	2.00N13.00E30WNE GD	0.1000	C
10	G	11171	G 10233	2.00N13.00E30WNE GD	0.4700	C
10	G	13247	G 11704	2.00N13.00E30WNE GD	1.1100	C
11	G	34	G 1487	2.00N13.00E30SWNE MU	0.2500	C
12	U	442	U 413	2.00N13.00E29SWNE IS	0.3100	C
13	G	4030	G 3794	2.00N13.00E29NESW IR	0.0400	C
13	G	4030	G 3794	2.00N13.00E29NESW IS	0.0600	C
14	G	2307	G 2127	2.00N13.00E30NESW MU	0.3000	C
14	G	7447	G 6941	2.00N13.00E30NESW MU	0.7000	C
14	U	127	U 121	2.00N13.00E30NESW IR	0.6700	C
15	G	471	G 338	2.00N13.00E28NWSW IM	2.9000	C
15	G	734	G 645	2.00N13.00E28NWSW IM	1.1100	C
16	T	5607	CG 646	2.00N13.00E28NESW IM	1.2000	C
16	G	735	G 646	2.00N13.00E28NESW IM	1.2000	C


CONDITIONED WELLS WITHIN 5 MILES OF APPLICATION G 14580

\$RECNO	APPLICATION	PERMIT	LOC-QQ	CONDITION-CODE
1	G 13122	G 12175	2.00N12.00E16NWNE	7AG
1	G 13122	G 12175	2.00N12.00E16NWNE	7AR
1	G 13122	G 12175	2.00N12.00E16NWNE	7BG
1	G 13122	G 12175	2.00N12.00E16NWNE	7BR
1	G 13122	G 12688	2.00N12.00E16NWNE	

APPLICATION G 14580 FALLS WITHIN THESE QUAD(S)

THE DALLES NORTH

THE DALLES NORTH

The following OWRD Groundwater Management Areas are within the map extent:

\$RECNO	NAME1	NAME2	SUB-AREA	STATUS
1	THE DALLES			CRIT
2	THE DALLES	THREEMILE RESERVOIR		CRIT
