



FINAL PROOF MAP

Permit Number R-12194

Township 11 South, Range 40 East, W.M.

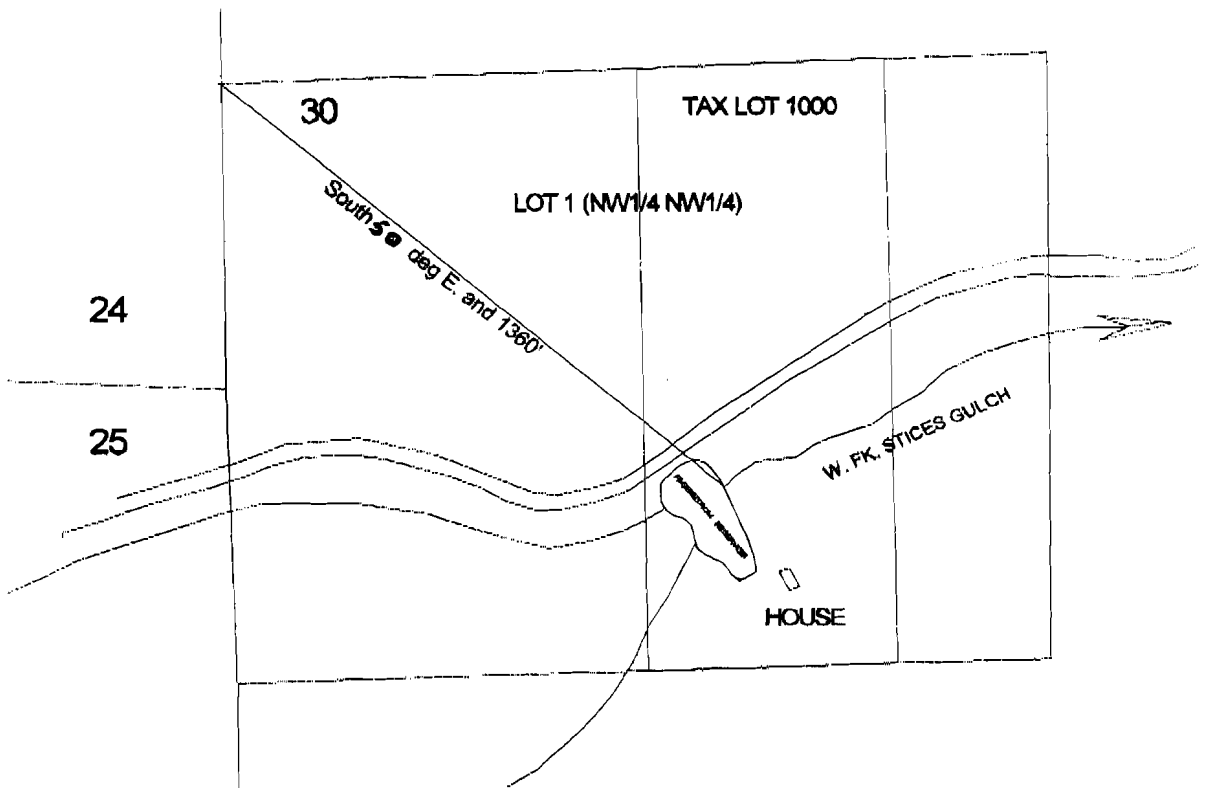

This map submitted by the reservoir owners, Cregor and Otilie Fagenstrom. This map is intended to show the location of the reservoir only and is not intended to show legal dimension of ownership

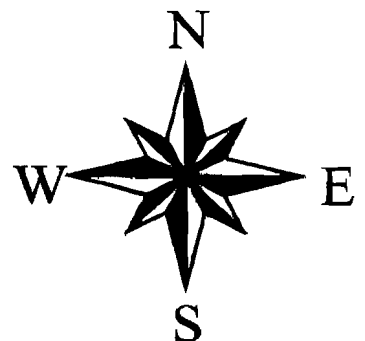

Map Scale 1" = 400'