
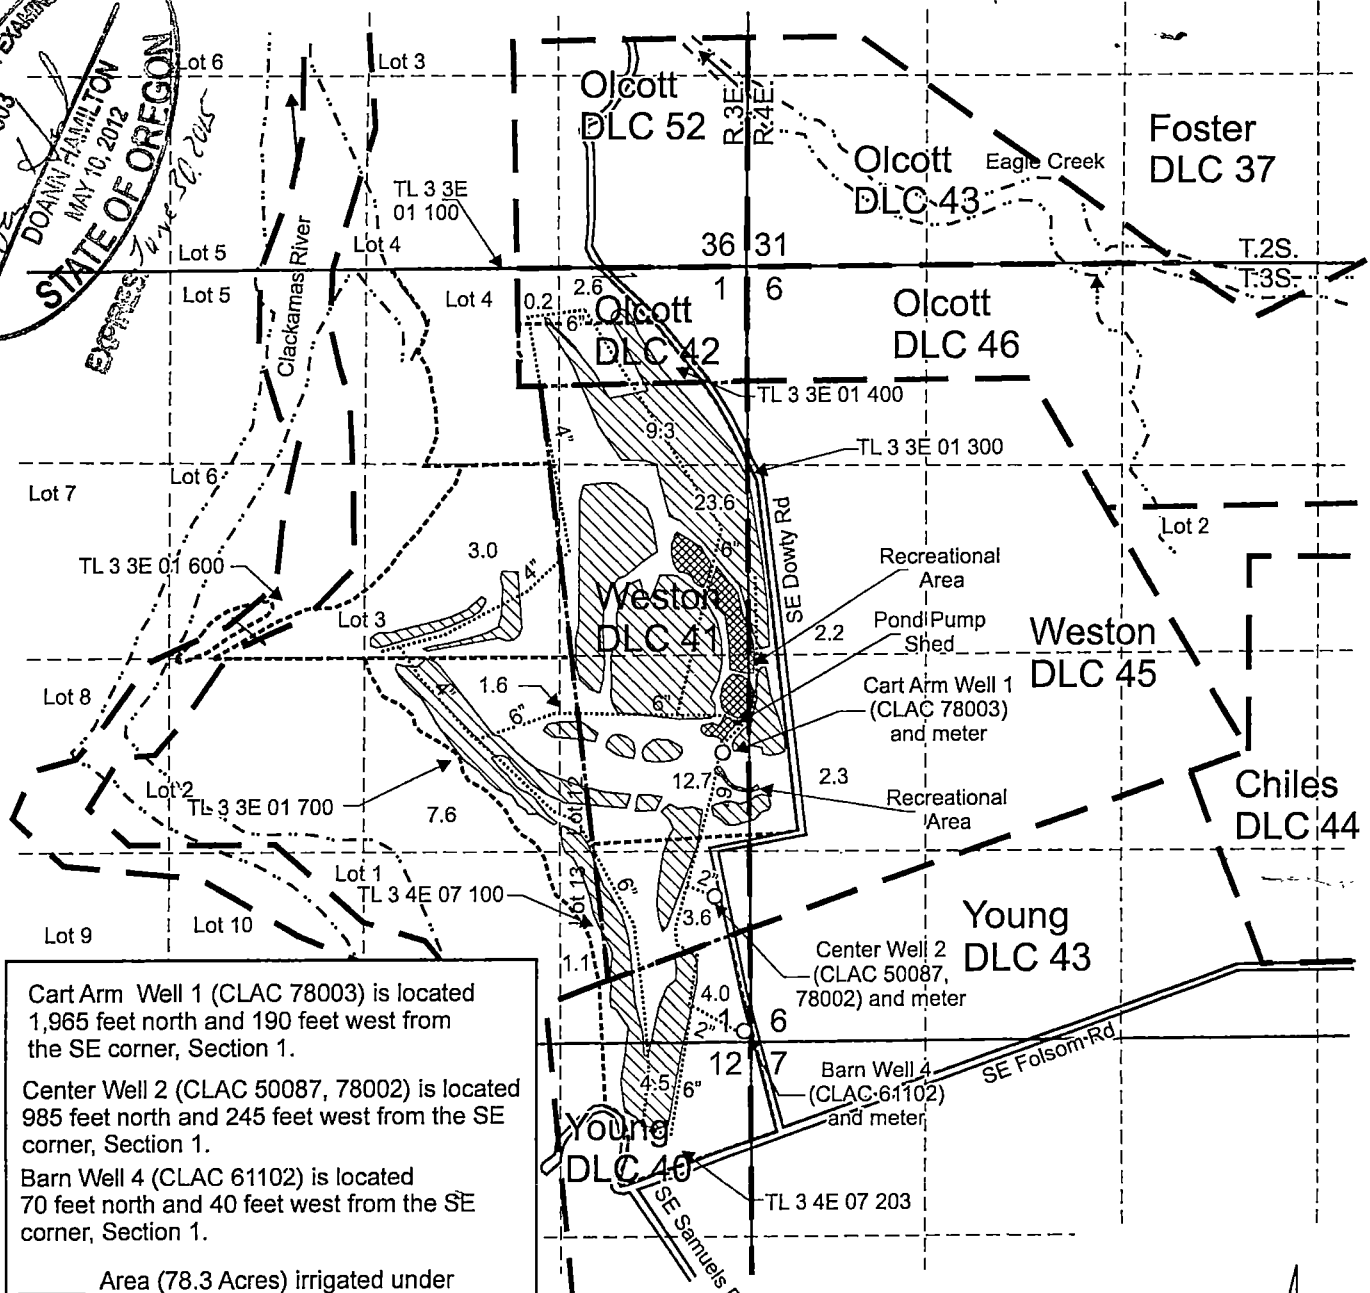


T.3S. R.3E. Sec. 1 & 12, and T.3S. R.4E. Section 6, W.M.

RECEIVED

MAY 11 2012

12:40

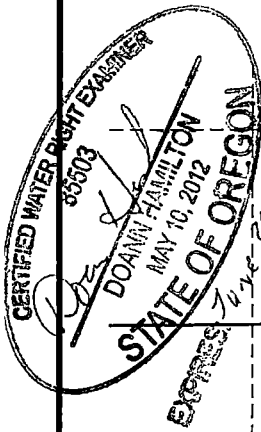

Cart Arm Well 1 (CLAC 78003) is located 1,965 feet north and 190 feet west from the SE corner, Section 1.


Center Well 2 (CLAC 50087, 78002) is located 985 feet north and 245 feet west from the SE corner, Section 1.

Barn Well 4 (CLAC 61102) is located 70 feet north and 40 feet west from the SE corner, Section 1.

Area (78.3 Acres) irrigated under Application G-12589, Permit G-18363, T-13051.

Recreation Water use area.

Tax lot boundary	Donation Land Claim boundary	Mainline Irrigation
------------------	------------------------------	---------------------

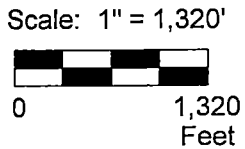

This map was prepared for the purpose of identifying the location of a water right only and is not intended to provide legal dimensions or location of property ownership lines.

Claim of Beneficial Use Map Application G-12589, Permit G-18363, T-13051

Eagle Creek Golf Course
T.3S. R.3E. Sec. 1 & 12
and T.3S. R.4E. Section 6, W.M.

Pacific Hydro-Geology Inc.

12/2023

Eagle Creek COBU Map.cdr