


T. 7 & 8 S., R. 2 W., W. M.

RECEIVED  
SEP 14 1996  
T. 7 S. R. 2 W. W. M.

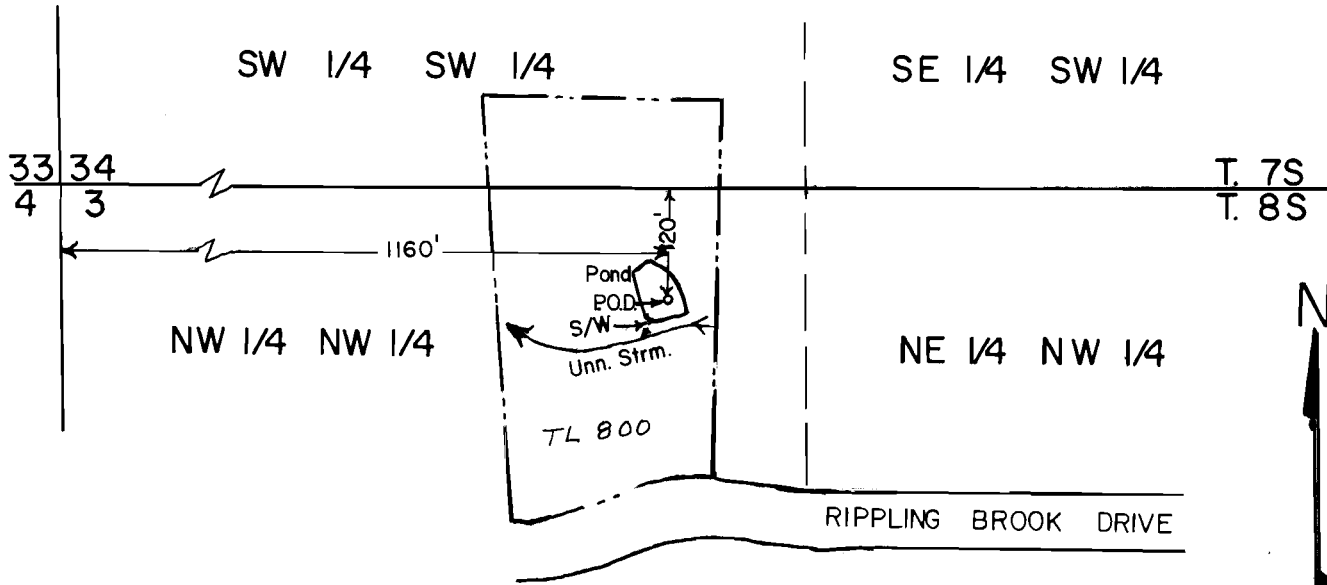

S/W = Spillway

1" = 200'  
(same as assessor's scale for this 1/4 section.)  
8S 2W 03B

### FINAL PROOF SURVEY

THIS MAP WAS PREPARED SOLELY FOR THE PURPOSE OF DEPICTING THE LOCATION OF A WATER RIGHT, AND HAS NO INTENTION OF BEING USED TO DETERMINE REAL PROPERTY BOUNDARIES.

Application No. R-74683 Permit No. R-11686

IN NAME OF

JAKE HURLBERT

Surveyed JULY 12, 1996, by T. Warren

