
T. 9 S. R. 2 W., W. M.

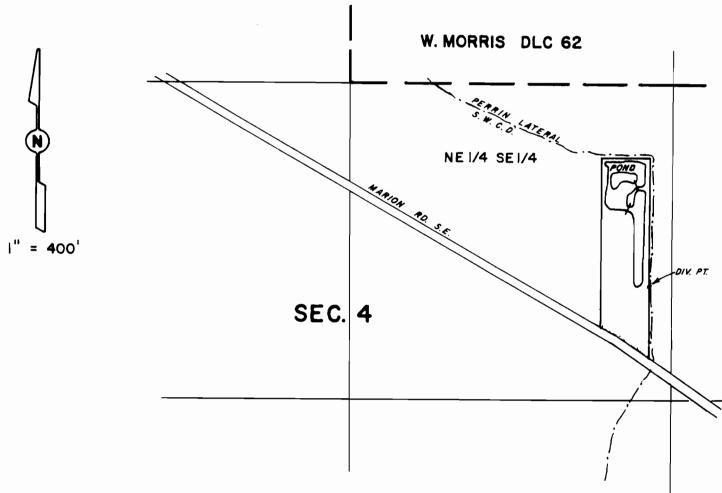

DIV. PT. LOC. 1250' E. & 850'S. FROM THE SW COR. OF W. MORRIS DLC 62

## **FINAL PROOF SURVEY** UNDER

Application No. R. 71.634 Permit No. R. 11.602. Water Right Exemu

IN NAME OF

GENE COLLIER

E OF ORE

THIS MAP WAS PREPARED FOR THE PURPOSE OF IDENTIFYING THE LOCA- Surveyed Mar. 29 19.91., by .. TION OF A WATER RIGHT ONLY AND IS Inspected Aug. 3, 1999 NOT INTENDED TO PROVIDE LEGAL DIMENSIONS OR LOCATION OF PROPER-TY OWNERSHIP LINES.