


T 6 S, R 4 W, W.M.

POLK COUNTY, OREGON

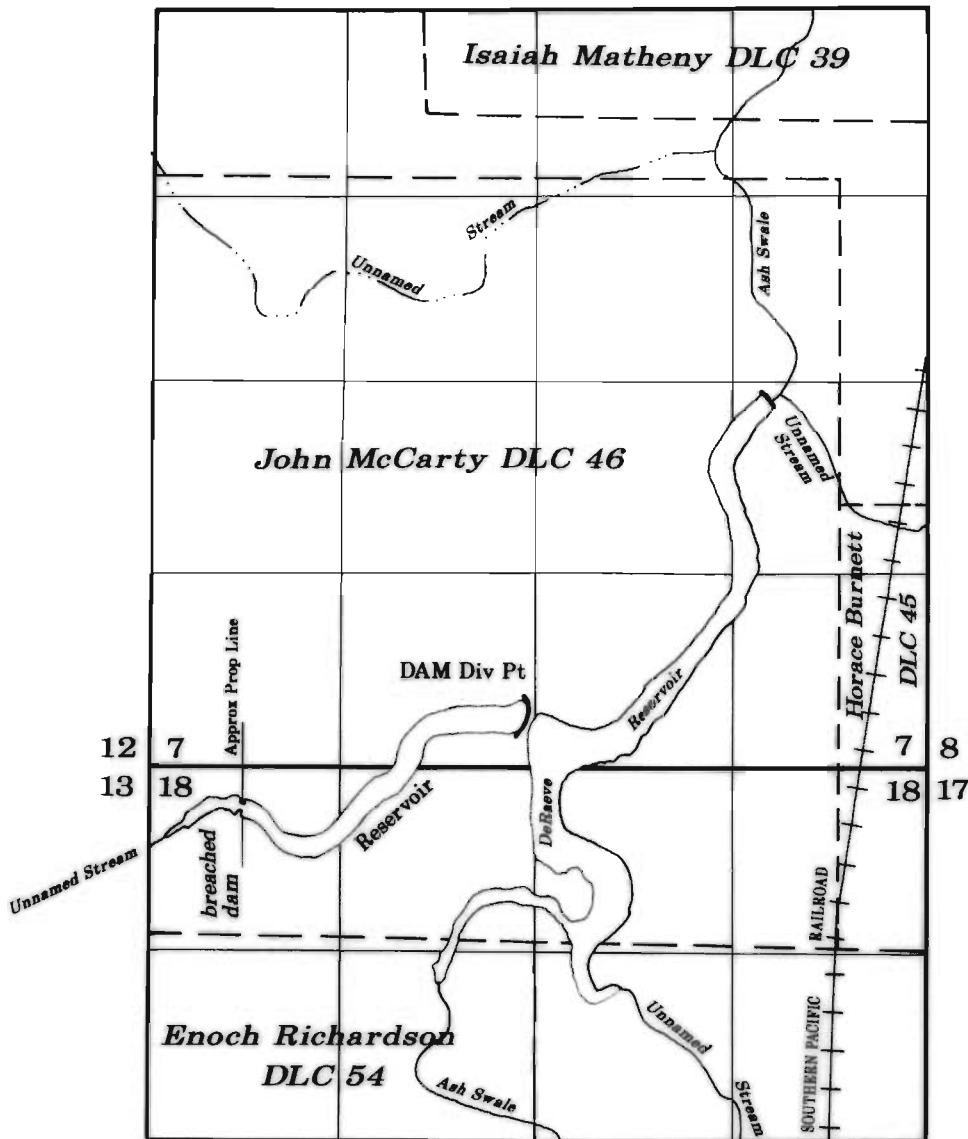

DIV PT: 3720' South and 2056' West of the NE corner of the John McCarty DLC 46.

FINAL PROOF SURVEY

UNDER

Application R-54226, R-67984, R-71578, Permit R-6486, R-10482, R-11459

IN NAME OF

Marvin DeRaeve

Surveyed: September 27, 1996

Scale: 1" = 1320'

NOTE: This map is for the purpose of identifying the location of water rights and has no intent to dimension or locate property ownership lines.

RECEIVED

OCT 21 1996

WATER RESOURCES DEPT.
SALEM, OREGON

