

FINAL PROOF SURVEY MAP

LOCATED IN THE N1/2NE1/4 OF SECTION 32
AND IN THE NW1/4NW1/4 OF SECTION 33
TOWNSHIP 40 SOUTH, RANGE 19 EAST, W.M.
LAKE COUNTY, OREGON

FOR
JOHN D. ALBERTSON
SUSAN C. ALBERTSON

RESERVOIR DATA

SURFACE AREA= 13.7 ACRES
AVERAGE DEPTH= 2.2 FEET
VOLUME OF RESERVOIR= 30.1 ACRE-Feet


APPLICATIONS AND PERMITS

APPLICATION: R-83937
PERMIT: R-12629

APPLICATION: R-84153
PERMIT: R-12828


DAM DETAIL

SCALE: 1"=40'

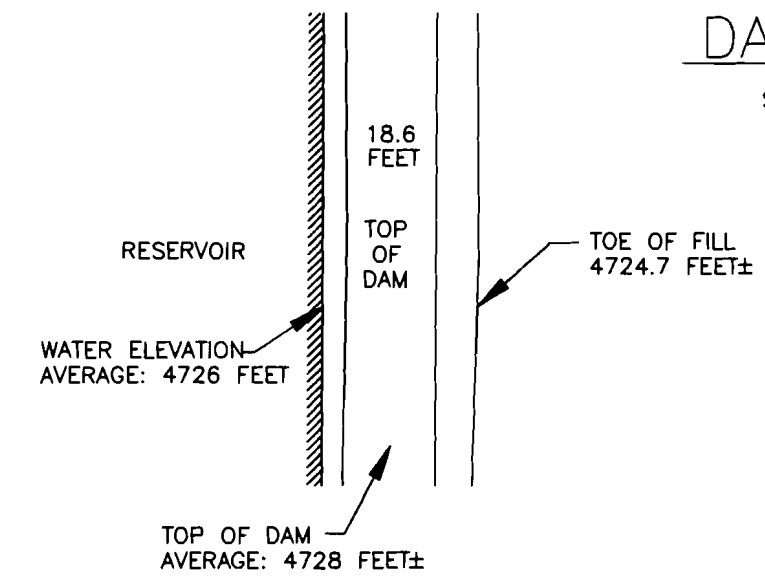


DAM CROSS SECTION

NO SCALE

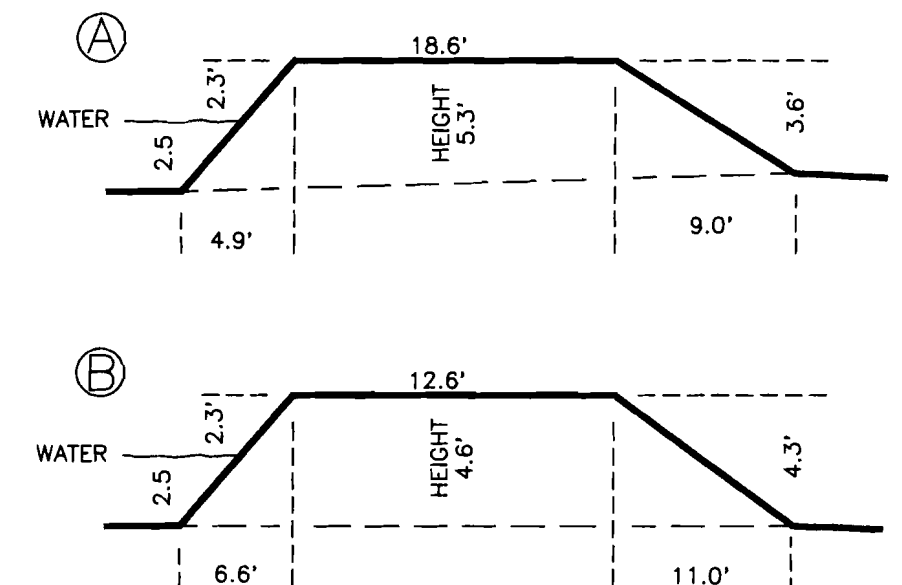

SPILLWAY DETAIL

SCALE: 1"=40'

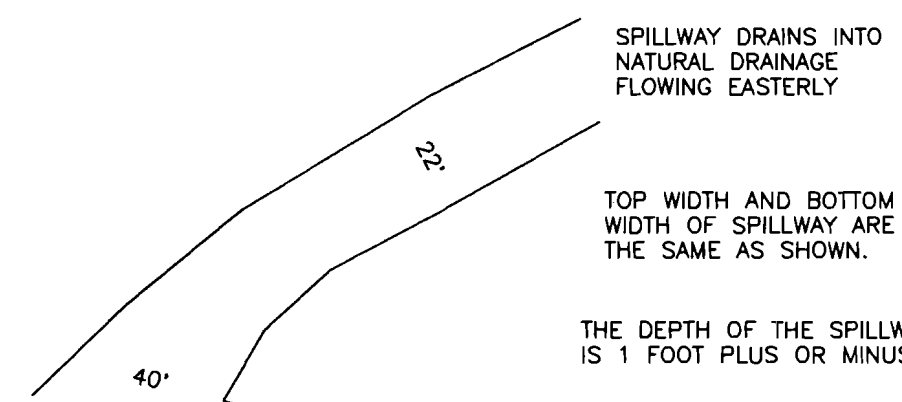

LAKE COUNTY ROAD #1-11J

ALBERTSON ROAD


NW1/4NE1/4
SECTION 32
TAX LOT: 40-19-7800

NE1/4NE1/4
SECTION 32
TAX LOT: 40-19-7800

NW1/4NW1/4
SECTION 33
A PORTION OF
TAX LOT: 40-19-7000

DAM TOP
WIDTH= 10 FEET

DAM TOP
WIDTH= 12 FEET

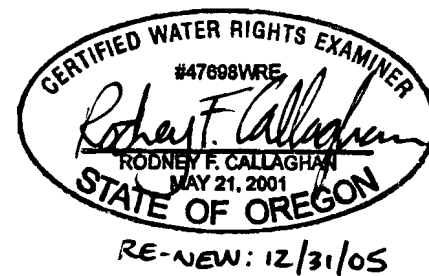

THIS MAP IS FOR THE PURPOSE OF LOCATING A
WATER RIGHT ONLY AND HAS NO INTENT TO PROVIDE
LEGAL DIMENSIONS OR THE LOCATION OF
PROPERTY LINES.

PREPARED FOR:
JOHN D. ALBERTSON
SUSAN C. ALBERTSON
14377 ALBERTSON ROAD
LAKEVIEW, OR 97630

PREPARED BY:
CLS
CALLAGHAN LAND SURVEYING
427 SOUTH H STREET
LAKEVIEW, OR 97630
(541) 947-5841

DATE: 8/24/2004

DRAWING: 200432

COBU MAP # 0145