


Township 10 South, Range 4 West, W.M.  
 Portions of Sections 5 & 6

RECEIVED

FEB 21 1995


WATER RESOURCES DEPT.  
 SALEM, OREGON

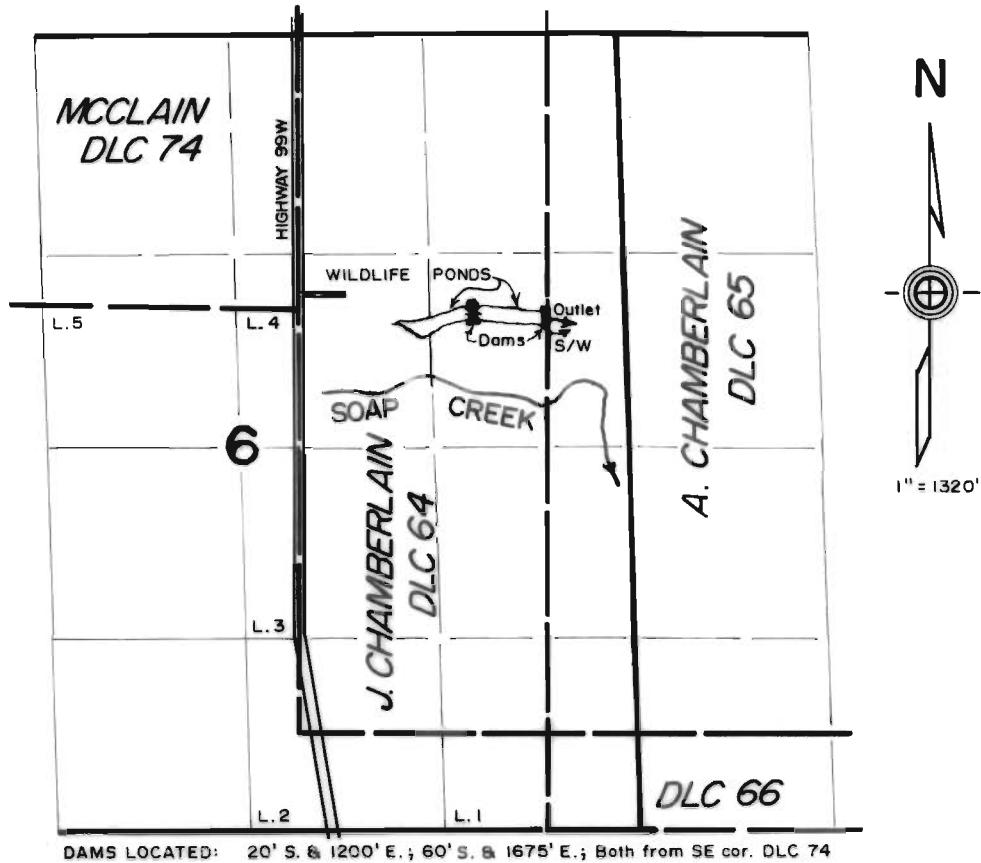

FINAL PROOF SURVEY  
 under  
 Appl. No. R-71524, Per. No. R-11407  
 in name of

GEORGE W. GORDON

February 3, 1995

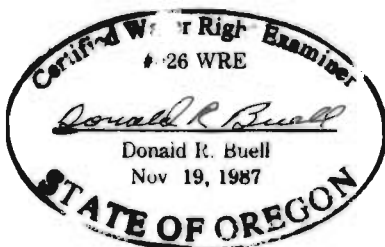

THIS MAP WAS PREPARED FOR THE PURPOSE OF IDENTIFYING THE LOCATION OF A WATER RIGHT ONLY AND IS NOT INTENDED TO PROVIDE LEGAL DIMENSIONS OR LOCATION OF PROPERTY OWNERSHIP LINES.